
## City of Prince George HISTORY SHEET

P.I.D. 026937719							
Legal: LOT 16			D.L.	482		PLAN BCP27961	
Address: 498 RAV COURT			SCALE: 1:500				
Sanitary Connection: SIZE:	100mmø	MATERIAL:	PVC	INV.	604.14m	CONNECTED	
Storm Connection:	N/A						
Water Connection: SIZE	19mmø	MATERIAL	COPPER	INV.	604.20m	METER	
Cash Receipt No's:	WATER		SANITARY			STORM	
CURB FROM PROPERTY LINE 5.0m					PAVEMEN	IT WIDTH 12.0m	
B.C. HYDRO 75mm DB2			U/G CONNECT	ION	<u> </u>		
TELUS 50mm DB2			U/G CONNECT	ION	/		
TERASEN 42 PROP/P.E.			U/G CONNECT	ION	_/		
Information Sheets: REF. DWGS. L&M ENGINEERING LTD. JOB. 1264-01-02 DWGS.(001-306)							
Comments: CS CURB STOP COO CLEAN OUT	-	ER SERVICE IITARY SERVI	се <u>=</u> 5	HYDRO CABLE TELEC	O SERVICE E SERVICE OMMUNICATIO	DNS	

THE INFORMATION CONTAINED HEREIN IS FOR INTERNAL USE ONLY.
NOT TO BE RELIED UPON UNLESS CONFIRMED BY THE SITE INSPECTION AND/OR INVESTIGATION

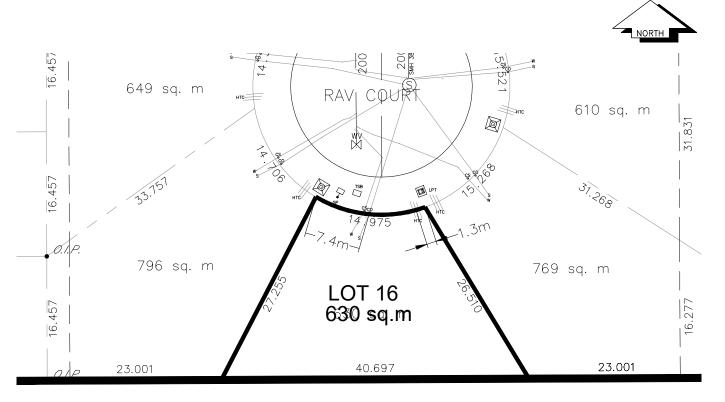

SANITARY, STORM & WATER SERVICE INVERTS	SANITARY	STORM	WATER
1. Distance from S.M.H. 388503 to connection point toward S.M.H. 388503	0.0m	N/A	N/A
2. Main Size at connection point is	200mmø	_	200mmø
3. Invert of main at conn. stub pt is	603.13	_	603.81
4. Invert at service end is	604.04	_	604.20
5. Cut at P/I in meters	2.71m	_	2.55m
6. Survey Date AUGUST 20 06 Book Ref. 1264-01-02 by FORESIGHT			
6. Survey Butto 718 8 8 8 1 20 8 8 Book Not.			
CANITADY LICTORY			
SANITARY HISTORY:			
WATER HISTORY:			
WALLY HISTORY.			
STORM HISTORY:			
STORM HISTORY.			