
City of Prince George HISTORY SHEET

P.I.D. 026937727							
Legal: LOT 17			D.L.	482		PLAN BCP27961	
Address: 492 RAV COURT			SCALE: 1:500				
Sanitary Connection: SIZE:	100mmø N	MATERIAL:	PVC	INV.	604.02m	CONNECTED	
Storm Connection:	N/A						
Water Connection: SIZE	19mmø N	MATERIAL	COPPER	INV.	603.74m	METER	
Cash Receipt No's:	WATER		SANITARY			STORM	
CURB FROM PROPERTY LINE 5.0m					PAVEMEN	IT WIDTH 12.0m	
B.C. HYDRO 75mm DB2			U/G CONNECTI	ON	_/_		
TELUS 50mm DB2			U/G CONNECTI	ON	/		
TERASEN 42 PROP/P.E.			U/G CONNECTI	ON	_/		
Information Sheets: REF. DWGS. L&M ENGINEERING LTD. JOB. 1264-01-02 DWGS.(001-306)							
Comments: CS CURB STOP COO CLEAN OUT	-	R SERVICE ARY SERVIC	E = ==================================	HYDRO CABLE TELEC	D SERVICE E SERVICE OMMUNICATIO	DNS	

THE INFORMATION CONTAINED HEREIN IS FOR INTERNAL USE ONLY.

NOT TO BE RELIED UPON UNLESS CONFIRMED BY THE SITE INSPECTION AND/OR INVESTIGATION

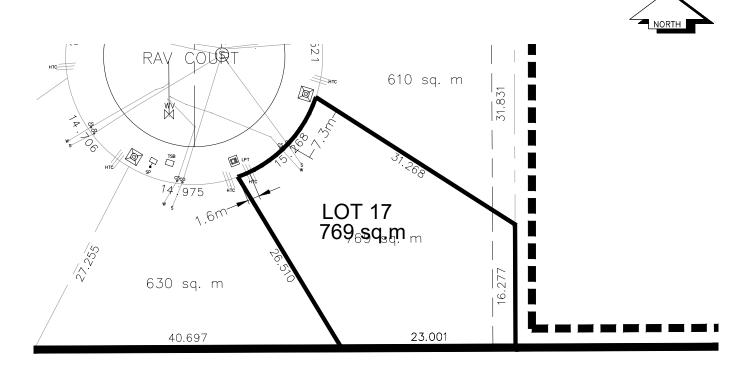

SANITARY, STORM & WATER SERVICE INVERTS	SANITARY	STORM	WATER
1. Distance from S.M.H. 388503 to connection point toward S.M.H. 388503	0.0m	N/A	N/A
2. Main Size at connection point is	200mmø	_	200mmø
3. Invert of main at conn. stub pt is	603.41	_	603.16
4. Invert at service end is	603.92	_	603.74
5. Cut at P/I in meters	2.75m	_	2.83m
6. Survey Date AUGUST 20 06 Book Ref. 1264-01-02 by FORESIGHT			
6. Survey Butte 718 8 8 8 1 1 20 8 8 Book Not.			
ONUTARY HISTORY			
SANITARY HISTORY:			
WATER HISTORY:			
WILLY HISTORY.			
STORM HISTORY:			
- STOCKWI THISTORY.			