

City of Prince George

HISTORY SHEET

P.I.D. 026937743

Legal: LOT 19

D.L. 482

PLAN BCP27961

Address: 480 RAV COURT

SCALE: 1:500

Sanitary Connection: SIZE: 100mm ϕ MATERIAL: PVC INV. 603.99m CONNECTED

Storm Connection: N/A

Water Connection: SIZE 19mm ϕ MATERIAL COPPER INV. 603.85m METER

Cash Receipt No's: WATER SANITARY STORM

CURB FROM PROPERTY LINE 3.0m PAVEMENT WIDTH 8.5m

B.C. HYDRO 75mm DB2 U/G CONNECTION ✓


TELUS 50mm DB2 U/G CONNECTION ✓

TERASEN 42 PROP/P.E. U/G CONNECTION ✓

Information Sheets: REF. DWGS. L&M ENGINEERING LTD. JOB. 1264-01-02 DWGS.(001-306)

Comments: CS₀ CURB STOP — W WATER SERVICE — H HYDRO SERVICE
CO₀ CLEAN OUT — S SANITARY SERVICE — C CABLE SERVICE
TELECOMMUNICATIONS

THE INFORMATION CONTAINED HEREIN IS FOR INTERNAL USE ONLY.
NOT TO BE RELIED UPON UNLESS CONFIRMED BY THE SITE INSPECTION AND/OR INVESTIGATION

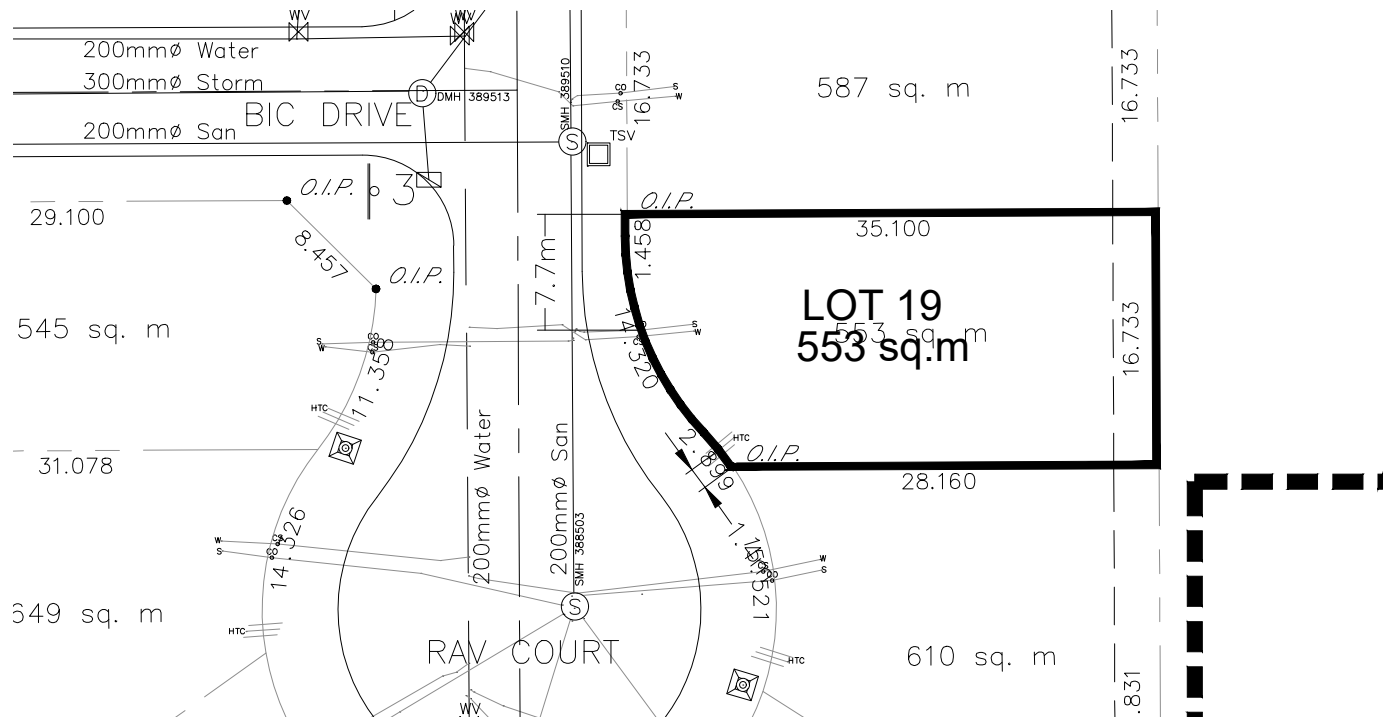

[illegible][illegible][illegible]