
## City of Prince George HISTORY SHEET

P.I.D. 026937808				
Legal: LOT 25		D.L.	482	PLAN BCP27961
Address: 429 TARA PLACE		SCALE: 1:500		
Sanitary Connection: SIZE:	100mmø MAT	TERIAL: PVC	INV. 604.15m	CONNECTED
Storm Connection:	N/A			
Water Connection: SIZE	19mmø MAT	TERIAL COPPER	INV. 604.04m	METER
Cash Receipt No's:	WATER	SANITARY		STORM
CURB FROM PROPERTY LINE 5.0m			PAVEMEN	IT WIDTH 12.0m
B.C. HYDRO 75mm DB2		U/G CONNECTION	ON /	
TELUS 50mm DB2		U/G CONNECTION	ON /	
TERASEN 42 PROP/P.E.		U/G CONNECTION	ON /	
Information Sheets: REF. DWGS.	L&M ENGINEERING LTI	D. JOB. 1264-01-02	DWGS.(001-306)	
Comments: CS CURB STOP COO CLEAN OUT	———> WATER S ——— SANITARY	SERVICE = 5	HYDRO SERVICE CABLE SERVICE TELECOMMUNICATIC	)NS

THE INFORMATION CONTAINED HEREIN IS FOR INTERNAL USE ONLY.
NOT TO BE RELIED UPON UNLESS CONFIRMED BY THE SITE INSPECTION AND/OR INVESTIGATION

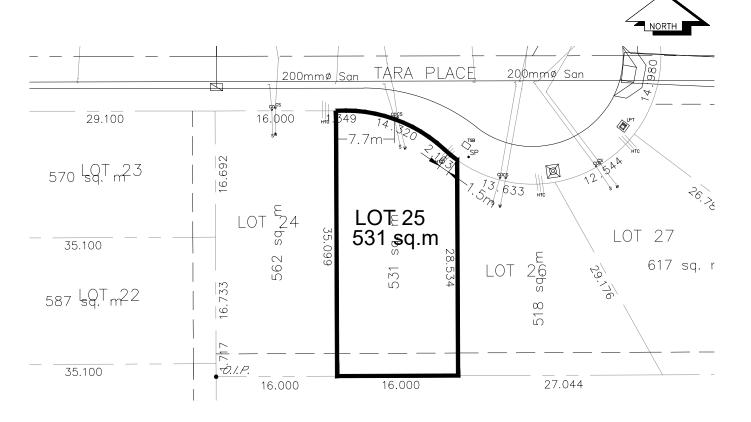

SANITARY, STORM & WATER SERVICE INVERTS	SANITARY	STORM	WATER
1. Distance from S.M.H. 389610 to connection point toward S.M.H. 389511	56.44m	N/A	N/A
2. Main Size at connection point is	200mmø	_	200mmø
3. Invert of main at conn. stub pt is	603.60	_	602.76
4. Invert at service end is	604.05	_	604.04
5. Cut at P/I in meters	2.28m	_	2.22m
6. Survey Date AUGUST 20 06 Book Ref. 1264-01-02 by FORESIGHT			
6. Sulvey back the edge 1 20 00 Book Not.			
SANITARY HISTORY:			
WATER AUGTORY			
WATER HISTORY:			
STORM HISTORY:			