


Lot Servicing

1689 BLACKBURN RD N

PID: 027073858

Lot: 1, Plan: BCP30117, DL: 632

SERVICE	SIZE	MATERIAL	INSTALLED DATE	LOCATION	DETAILS
WATER	20MM	CU	13-Aug-2007	8.2M S OF N PL	CASH RECEIPT NUMBER MU100685
SANITARY	100MM	PVC	13-Aug-2007	8.4M S OF N PL	CONNECTION # 33763

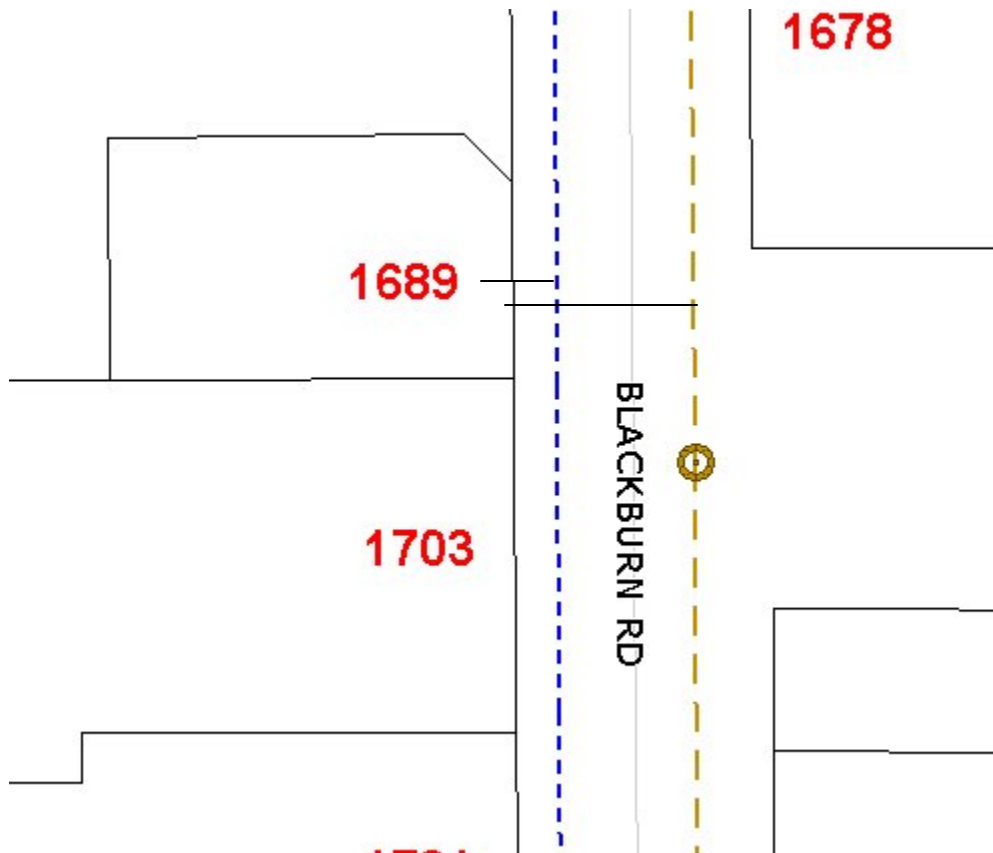

Accuracy not guaranteed unless confirmed by site inspection and/or investigation.
Connection location between main and property line only.