


## Lot Servicing

1643 BLACKBURN RD N  
Lot: 3, Plan: BCP30117, DL: 632

PID: 027073874

SERVICE	SIZE	MATERIAL	INSTALLED DATE	LOCATION	DETAILS
WATER	20MM	CU	13-Aug-2007	2.3M N OF S PL	CASH RECEIPT NUMBER MU100685
SANITARY	100MM	PVC	13-Aug-2007	1.9M N OF S PL	CONNECTION # 33763

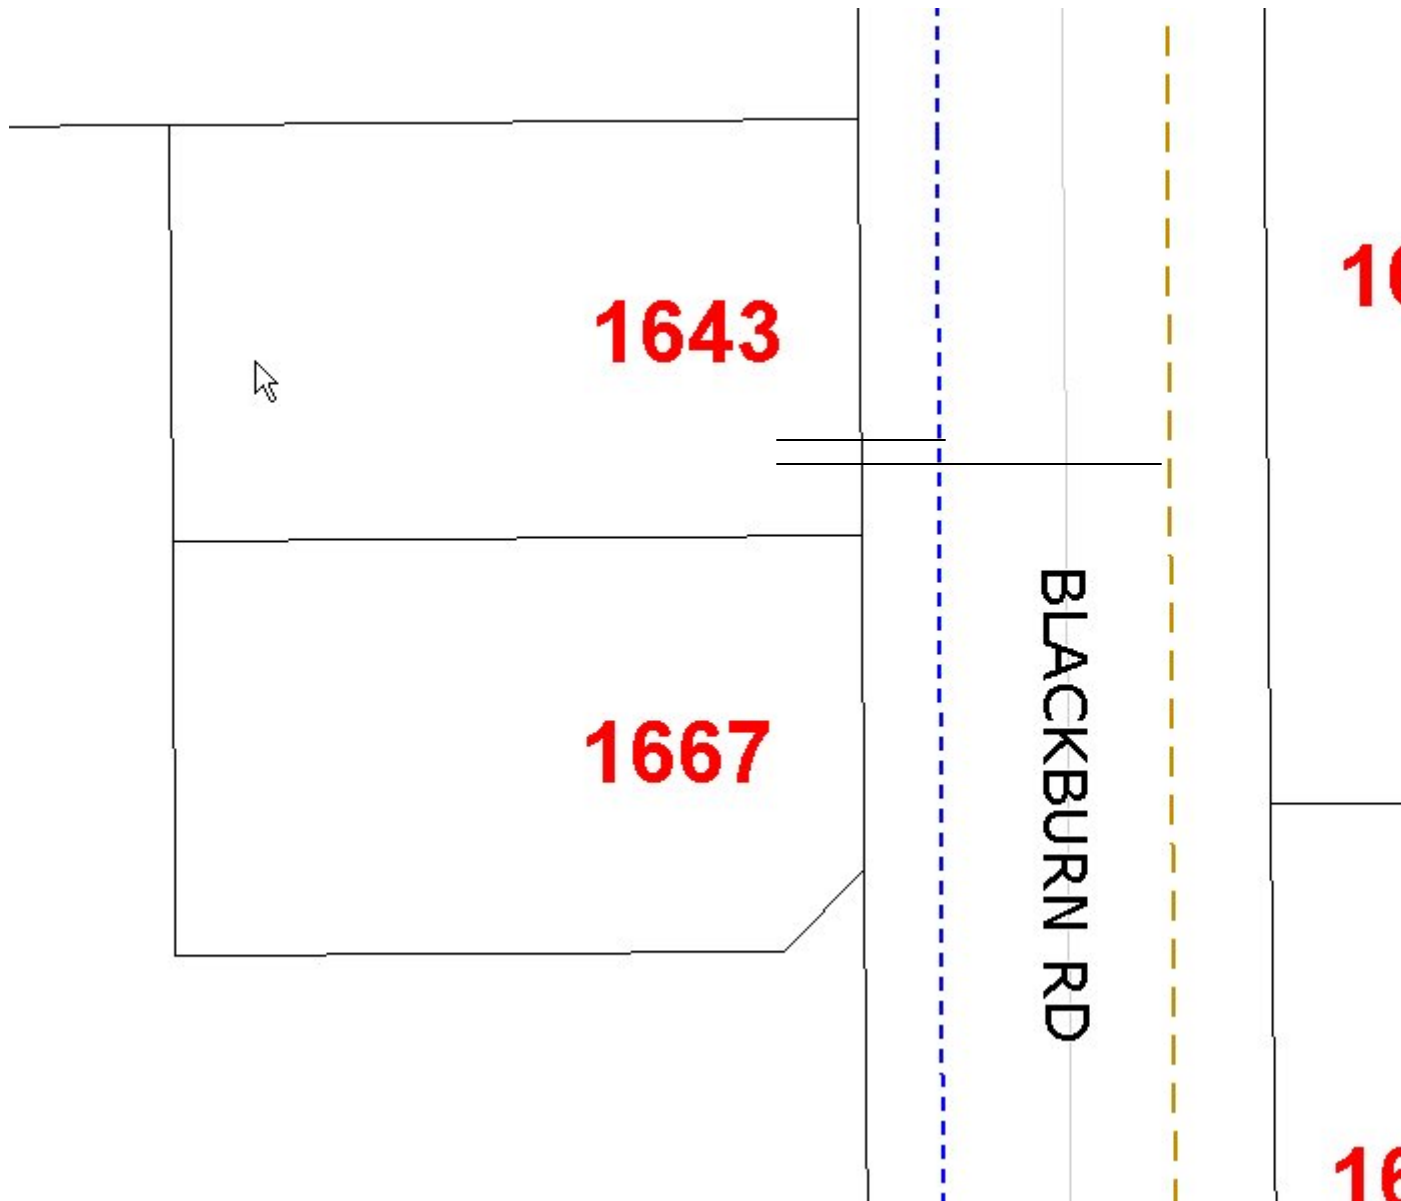

Accuracy not guaranteed unless confirmed by site inspection and/or investigation.  
Connection location between main and property line only.

