


Lot Servicing

Lot Servicing

1533 BLACKBURN RD N
Lot: 4, Plan: BCP30117, DL: 632

PID: 027073882

SERVICE	SIZE	MATERIAL	INSTALLED DATE	LOCATION	DETAILS
WATER	20MM	CU	13-Aug-2007	6.8M S OF N PL	CASH RECEIPT NUMBER MU100685
SANITARY	100MM	PVC	13-Aug-2007	7.0M S OF N PL	CONNECTION # 33763

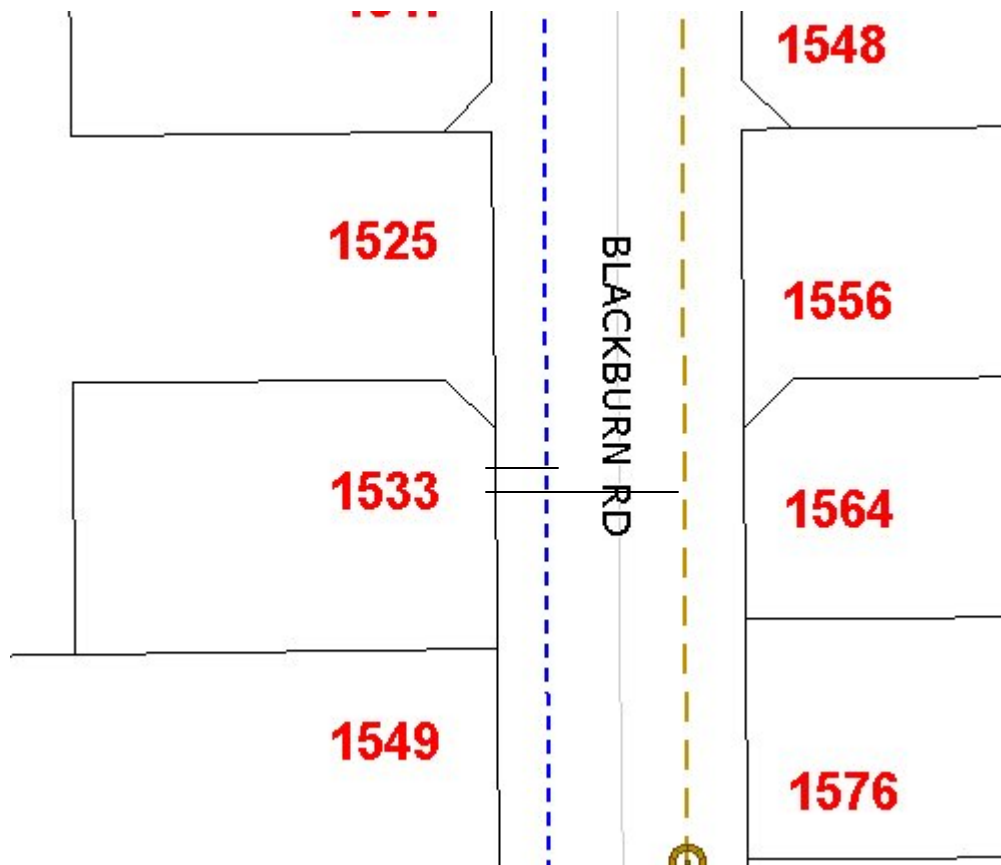

Accuracy not guaranteed unless confirmed by site inspection and/or investigation.
Connection location between main and property line only.