


Lot Servicing

1564 BLACKBURN RD N
Lot: 5, Plan: BCP30117, DL: 633

PID: 027073891

SERVICE	SIZE	MATERIAL	INSTALLED DATE	LOCATION	DETAILS
WATER	20MM	CU	13-Aug-2007	8.7M N OF S PL	CASH RECEIPT NUMBER MU100685
SANITARY	100MM	PVC	13-Aug-2007	8.6M N OF S PL	CONNECTION # 33763

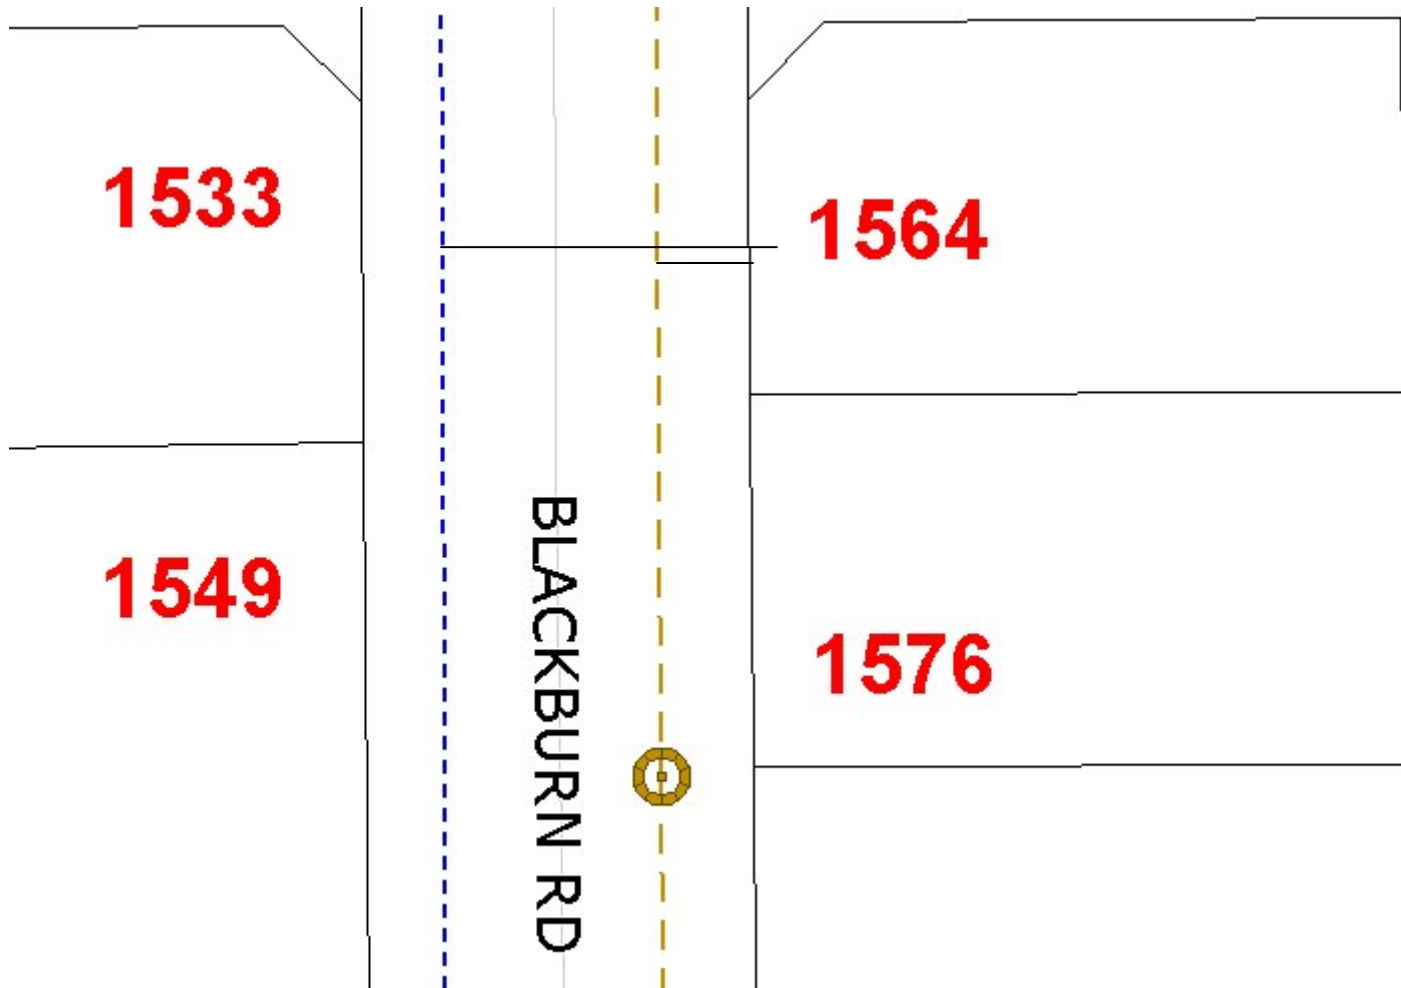

Accuracy not guaranteed unless confirmed by site inspection and/or investigation.
Connection location between main and property line only.