


## Lot Servicing

1576 BLACKBURN RD N  
Lot: 6, Plan: BCP30117, DL: 633

PID: 027073904

SERVICE	SIZE	MATERIAL	INSTALLED DATE	LOCATION	DETAILS
WATER	20MM	CU	13-Aug-2007	8.1M S OF N PL	CASH RECEIPT NUMBER MU100685
SANITARY	100MM	PVC	13-Aug-2007	8.4M S OF N PL	CONNECTION # 33763

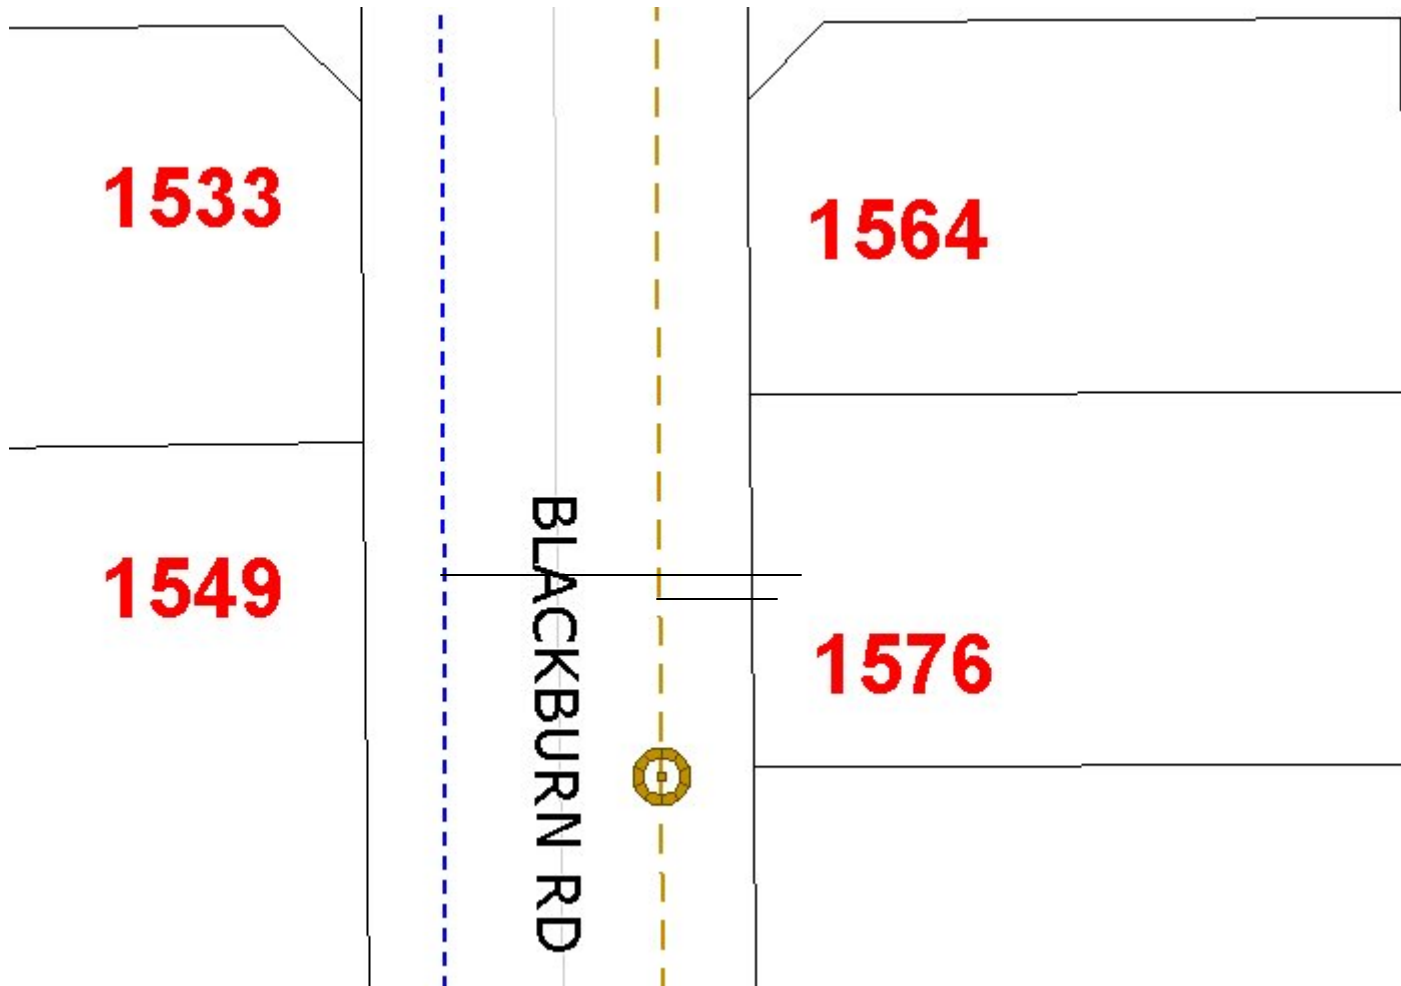

Accuracy not guaranteed unless confirmed by site inspection and/or investigation.  
Connection location between main and property line only.