


Lot Servicing

7115 IRENE RD

PID: 027087727

Lot: B, Plan: BCP30337, DL: 1599

| SERVICE | SIZE | MATERIAL | INSTALLED DATE | LOCATION | DETAILS |
|----------|-------|----------|----------------|----------------------|-----------------------------|
| WATER | 20MM | CU | 30-Aug-1982 | SP 12.6M S OF N PL | CASH RECEIPT NUMBER 1190 |
| SANITARY | 100MM | UNKNOWN | | 22.0M S OF NE COR PL | CLEANOUT 12.9M S OF N PL |
| | | | | | |

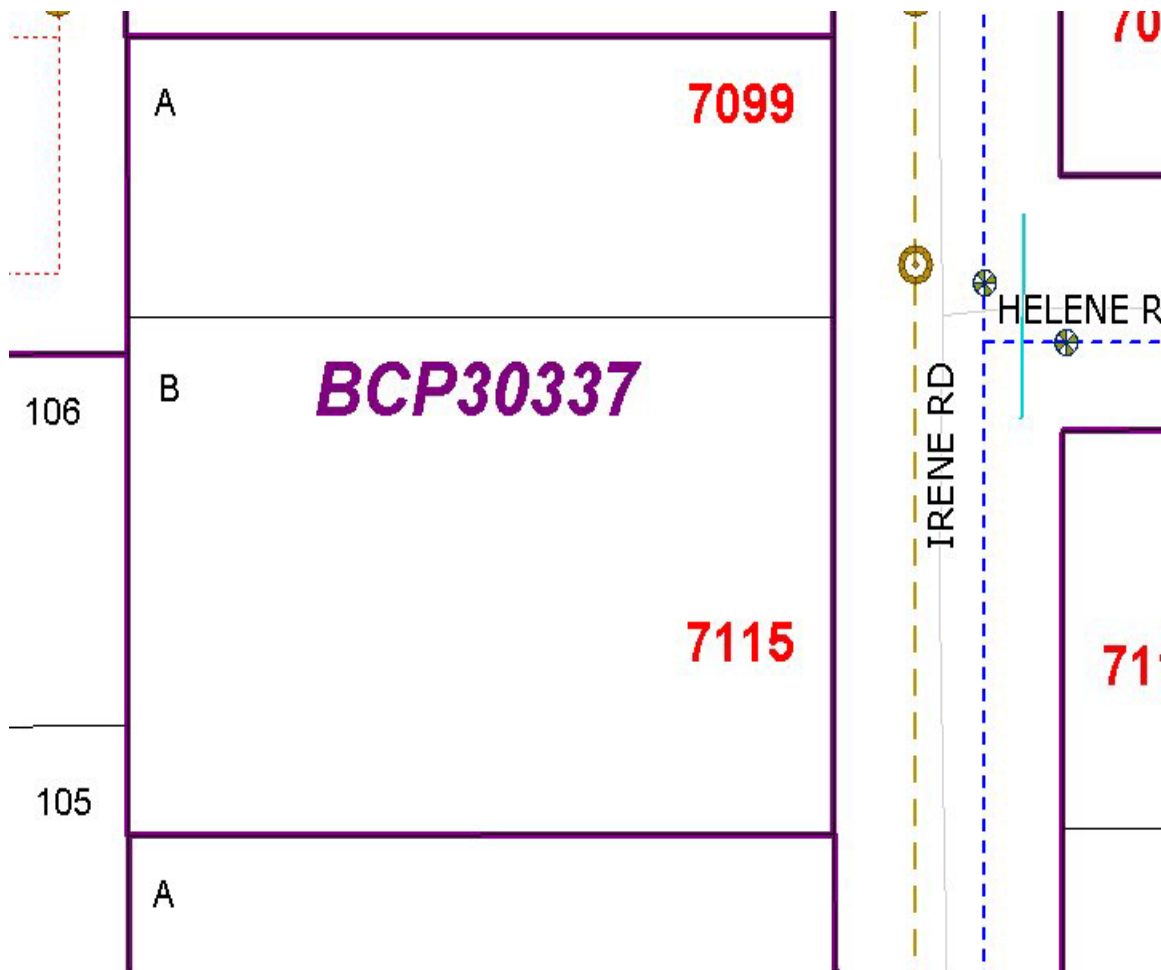

Accuracy not guaranteed unless confirmed by site inspection and/or investigation.
Connection location between main and property line only.