


Lot Servicing

8828 KELLY RD N
Lot: 1, Plan: BCP29568, DL: 2432

PID: 027087735

SERVICE	SIZE	MATERIAL	INSTALLED DATE	LOCATION	DETAILS
WATER	20MM	CU		26.4M S OF N PL	CASH RECEIPT NUMBER MU100670
SANITARY	100MM	PVC		C/O 28.3M S OF N PL	CLEANOUT Y

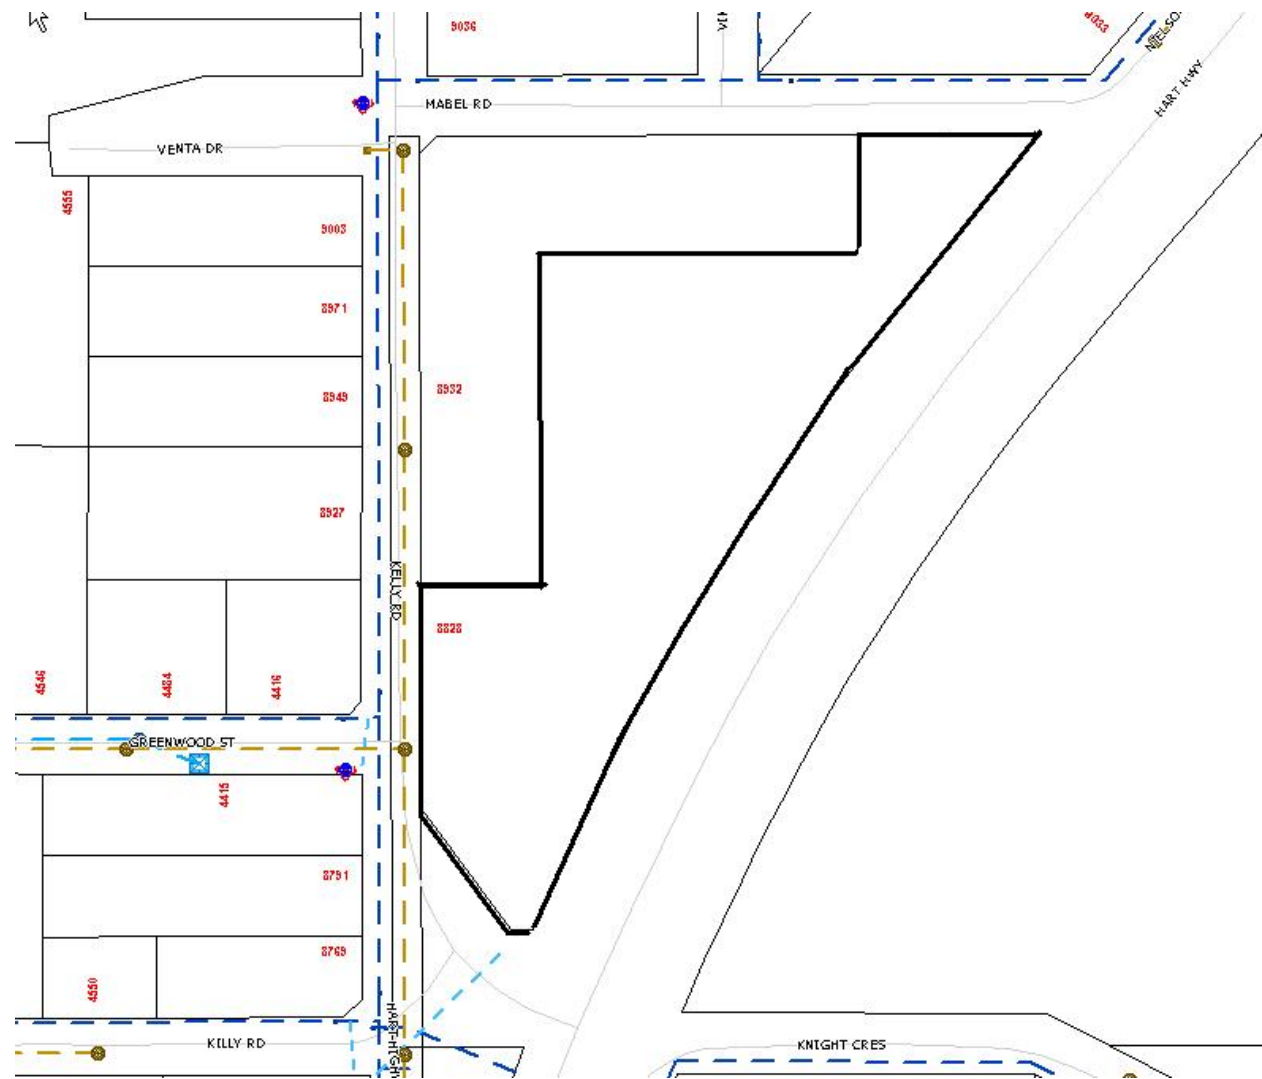

Accuracy not guaranteed unless confirmed by site inspection and/or investigation.
Connection location between main and property line only.