


Lot Servicing

2910 ANDRES RD

PID: 027097625

Lot: C, Plan: BCP30664, DL: 1433

| SERVICE | SIZE | MATERIAL | INSTALLED DATE | LOCATION | DETAILS |
|----------|-------|----------|----------------|-------------------------|------------------------------|
| WATER | 20MM | CU | | SP 6.1M W OF E PL | CASH RECEIPT NUMBER MU100654 |
| SANITARY | 100MM | PVC | | 6.8M W OF E PL | CLEANOUT 7.0M W OF E PL |
| STORM | 100MM | PVC | 31-Jul-2007 | NEW INSTALL NO LOCATION | CONNECTION # 35164 |

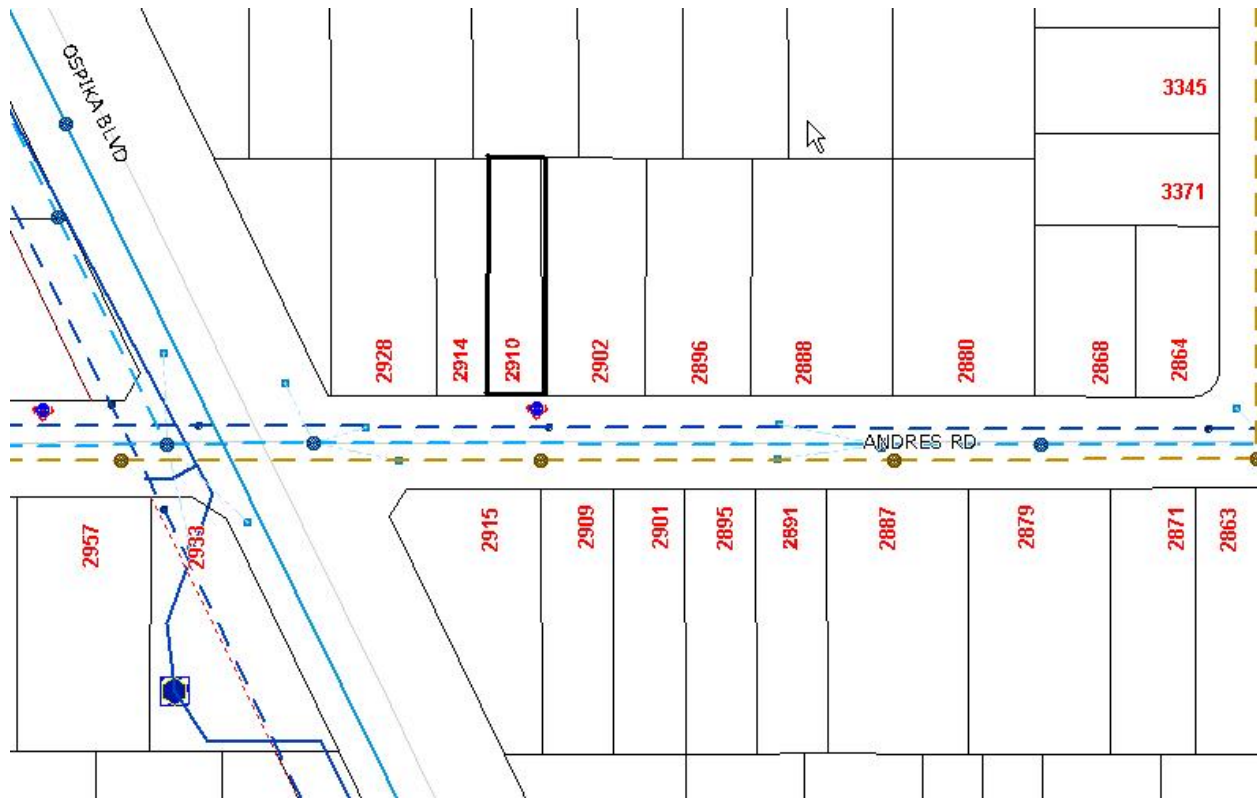

Accuracy not guaranteed unless confirmed by site inspection and/or investigation.
Connection location between main and property line only.