
Lot Servicing

PID: 027098079

1483 MILBURN AVE 1487 MILBURN AVE

Lot: PCL 1, Plan: 22118, DL: 932

SERVICE	SIZE	MATERIAL	INSTALLED DATE	LOCATION	DETAILS
WATER	20MM	CU		14.0M N OF NE COR BLD 6.4M W	CASH RECEIPT NUMBER 0359
WATER	20MM	СП		14.0M N OF NW COR BLD 7.0M E	CONNECTION NUMBER 9621
SANITARY	100MM	AC		8.23M W OF NE COR PL	CONNECTION # 9620
SANITARY	100MM	AC		8.23M E OF NW COR PL	CONNECTION # 9621

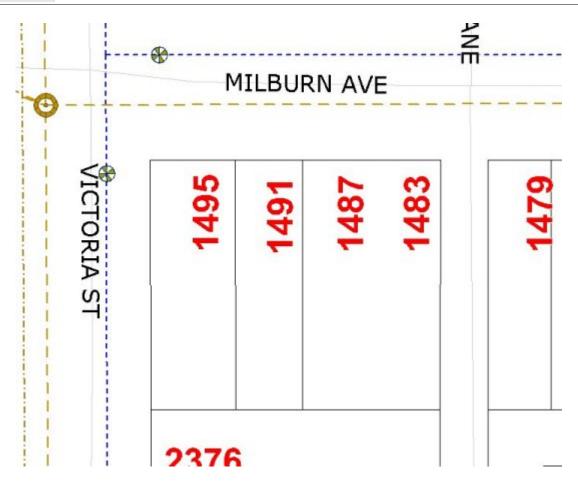

Accuracy not guaranteed unless confirmed by site inspection and/or investigation. Connection location between main and property line only.