


Legal Description: Lot: 30 District Lot: 1599 Plan: BCP30864

Service Type	Diameter (mm)	Material	Invert Elev Invert Elev @ @ Main (m) Property Line (m)		Invert Elev @ Service End (m)		Distance into Property (m)		nstallation Date	
Sanitary	100	PVC	-	-		-		-		FEB 2005
Water	20	COPPER	-	-		-		-		FEB 2005
Storm	100	PVC	-	-		-		-		FEB 2005
Sanitary Service Connection Location Notes					Storm Service Connection Location Notes					
Distance from downstream SAN MH #5252: 0.00m					Distance from downstream STM MH #3814: 0.00m					
Distance to upstream SAN MH #5252: 0.00m					Distance to upstream STM MH #3814: 0.00m					
			Mis	cellaned	ous Utilities					
Power		C	Communications		Cable			Gas		
BC Hydro			TELUS		Shaw Cable			FortisBC		
Underground Service		Un	Underground Service		Underground Service			Underground Service		
Installation By: L&M Engineering LTD.						Draft Date:	2023-	02-22 <b>S</b>	urvey Date:	FEB 2005

Comments:

Sanitary Service is ~7.6m Northeast from the Southwest corner of Lot 30. Storm Service is ~9.0m Northeast from the Southwest corner of Lot 30.

Water Service is ~10.6m Northeast from the Southwest corner of Lot 30.

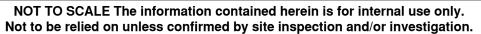

	EALCHMBRAM
200mm Ø PVC SANITARY MAIN	LOT 30
BEARSPAW CRT 3 D-MH #3814 S-MH #5252	
300mm Ø PVC STORM MAIN	
300mm Ø PVC STORM MAIN J 150mm Ø PVC WATER MAIN	
- $       +$ $ +$ WATER HYDRANT LEAD, VALVE, HYDRANT	
	SANITARY MAIN
D STORM SERVICE	
ROAD EDGE	