

City of Prince George

HISTORY SHEET

PID: 027141071

Scale: 1:500

Legal: LOT 3

D.L.: 905

PLAN: BCP31387

Address: 4186 PRUDENTE RD

Sanitary Connection:# SIZE: 100mmØ MATERIAL: PVC INV. 643.91m CONNECTED

Water Connection:# SIZE: 19mmØ MATERIAL: COPPER INV. 643.87m METER

Storm Connection:# SIZE: 100mmØ MATERIAL: PVC INV. 643.91m CONNECTED

Cash Receipt No's: WATER SANITARY STORM

CURB FROM PROPERTY LINE 5.0m PAVEMENT WIDTH 10.0m

B.C. HYDRO 75mm DB2 U/G CONNECTION ✓

B.C. TELEPHONE 50mm DB2 U/G CONNECTION ✓


B.C. GAS 42 PROP/P.E.

Information Sheets: REFERENCE DRAWINGS L&MENGINEERING LIMITED JOB NO. 1292-01-04

Comments: CS • CURB STOP CO • CLEAN OUT SDW WATER SERVICE STORM SERVICE SANITARY SERVICE HCH HYDRO SERVICE CABLE SERVICE TELECOMMUNICATIONS GAS GAS E ELECTRICAL

THE INFORMATION CONTAINED HEREIN IS FOR INTERNAL USE ONLY.

NOT TO BE RELIED UPON UNLESS CONFIRMED BY THE SITE INSPECTION AND/OR INVESTIGATION

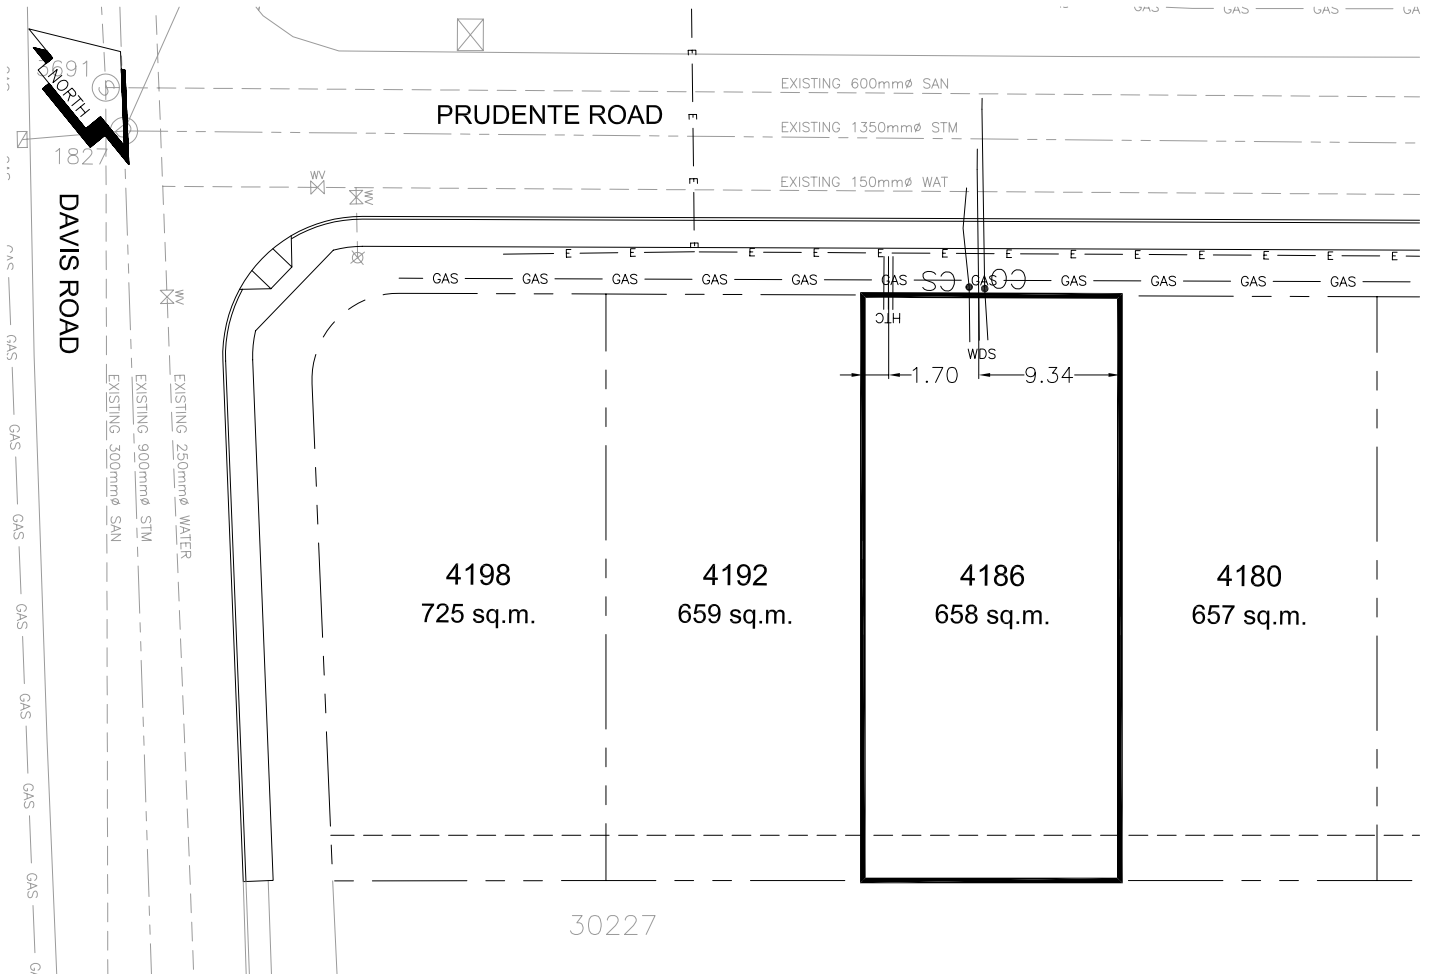

SANITARY, STORM & WATER SERVICE INVERTS	SANITARY	WATER	STORM
1. Distance from San. M.H. <u>3691</u> toward San. M.H. <u>3688</u> to lot service connection point is:	57.96m	-	-
1a.Distance from Stm. M.H. <u>1827</u> toward Stm. M.H. <u>1825</u> to lot service connection point is:	-	-	56.44m
2. Main Size at connection point is	600mmØ	150mmØ	1350mmØ
3. Invert of main at conn. stub pt is	641.88m	642.66m	641.82m
4. Invert at service end is	643.91m	643.87m	643.91m
5. Cover at P/I in meters	2.15m	2.29m	2.22m
6. Survey Date: - Book Ref.: - By: FORESIGHT SURVEY & DESIGN Ltd.			

SANITARY HISTORY:

DATE INSTALLED: JUNE 2007

INSTALLED BY: WESTERN INDUSTRIAL CONTRACTORS LTD

WATER HISTORY:

DATE INSTALLED: JUNE 2007

INSTALLED BY: WESTERN INDUSTRIAL CONTRACTORS LTD

STORM HISTORY:

DATE INSTALLED: JUNE 2007

INSTALLED BY: WESTERN INDUSTRIAL CONTRACTORS LTD