

# City of Prince George

## HISTORY SHEET

PID: 027141080

Scale: 1:500

Legal: LOT 4

D.L.: 905

PLAN: BCP31387

Address: 4180 PRUDENTE RD

Sanitary Connection:#	SIZE: 100mmØ	MATERIAL: PVC	INV. 643.55m	CONNECTED
-----------------------	--------------	---------------	--------------	-----------

Water Connection:#	SIZE: 19mmØ	MATERIAL: COPPER	INV. 643.20m	METER
--------------------	-------------	------------------	--------------	-------

Storm Connection:#	SIZE 100mmØ	MATERIAL PVC	INV. 643.51m	CONNECTED
--------------------	-------------	--------------	--------------	-----------

Cash Receipt No's:	WATER	SANITARY	STORM
--------------------	-------	----------	-------

CURB FROM PROPERTY LINE	5.0m	PAVEMENT WIDTH	10.0m
-------------------------	------	----------------	-------

B.C. HYDRO	75mm DB2	U/G CONNECTION	✓
------------	----------	----------------	---


B.C. TELEPHONE	50mm DB2	U/G CONNECTION	✓
----------------	----------	----------------	---

B.C. GAS	42 PROP/P.E.
----------	--------------

Information Sheets: REFERENCE DRAWINGS L&MENGINEERING LIMITED JOB NO. 1292-01-04

Comments:	CS • CURB STOP CO • CLEAN OUT	SDW WATER SERVICE SDW STORM SERVICE SDW SANITARY SERVICE	CH HYDRO SERVICE CH CABLE SERVICE CH TELECOMMUNICATIONS	GAS GAS E ELECTRICAL
-----------	----------------------------------	--	---	-------------------------

THE INFORMATION CONTAINED HEREIN IS FOR INTERNAL USE ONLY.  
 NOT TO BE RELIED UPON UNLESS CONFIRMED BY THE SITE INSPECTION AND/OR INVESTIGATION

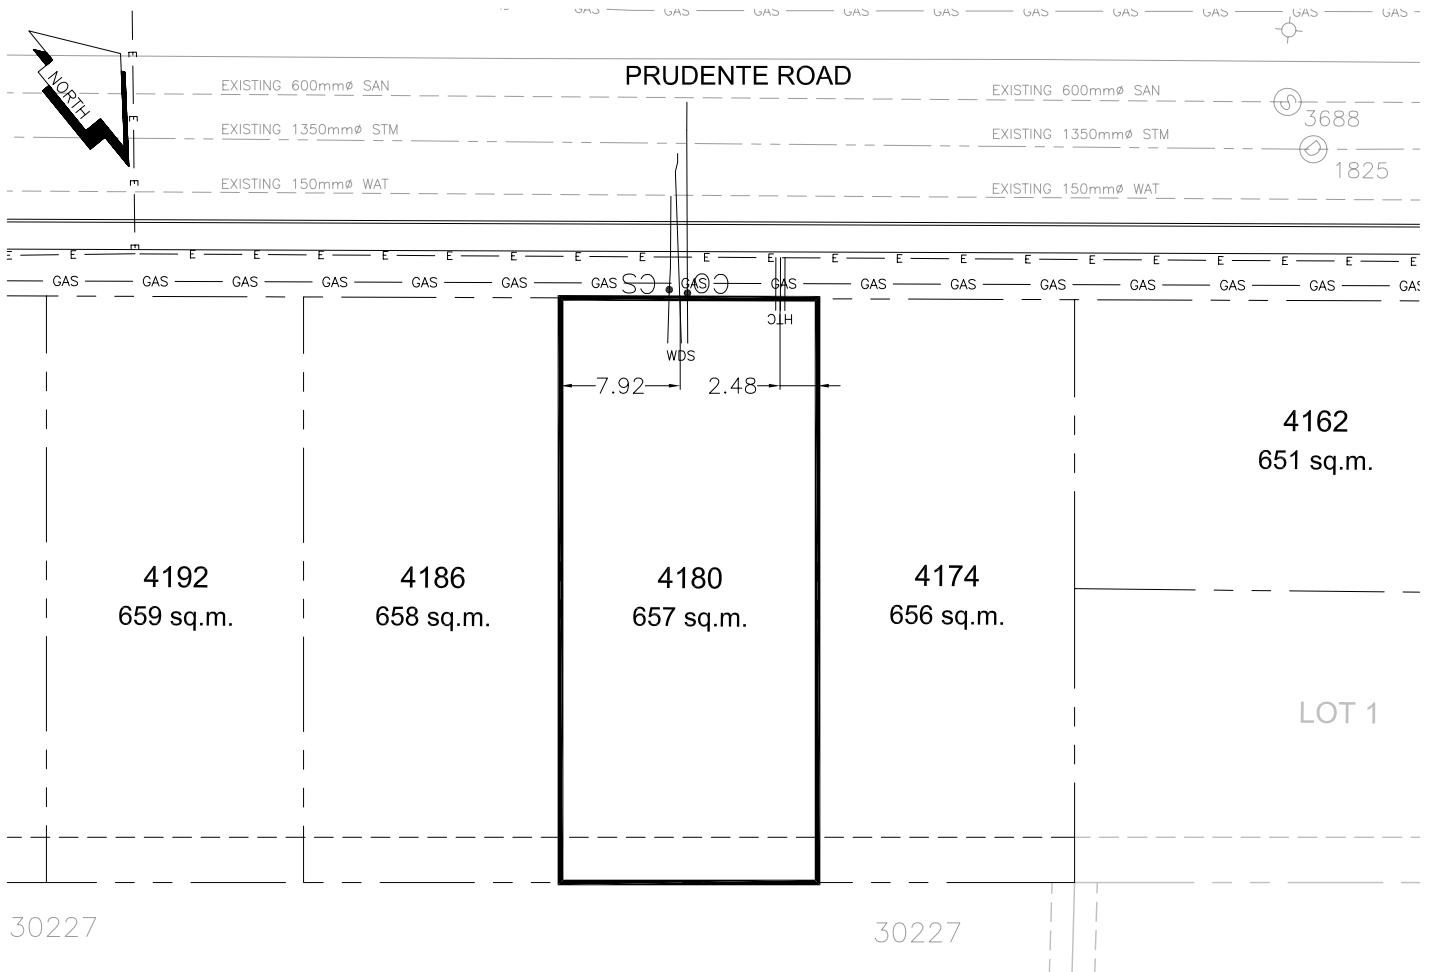

SANITARY, STORM & WATER SERVICE INVERTS	SANITARY	WATER	STORM
1. Distance from San. M.H. <u>3691</u> toward San. M.H. <u>3688</u> to lot service connection point is:	75.43m	-	-
1a.Distance from Stm. M.H. <u>1827</u> toward Stm. M.H. <u>1825</u> to lot service connection point is:	-	-	73.62m
2. Main Size at connection point is	600mmØ	150mmØ	1350mmØ
3. Invert of main at conn. stub pt is	641.60m	642.40m	641.32m
4. Invert at service end is	643.55m	643.20m	643.51m
5. Cover at P/I in meters	2.32m	2.78m	2.43m
6. Survey Date: -      Book Ref.: -      By: FORESIGHT SURVEY & DESIGN Ltd.			

SANITARY HISTORY:

DATE INSTALLED: JUNE 2007

INSTALLED BY: WESTERN INDUSTRIAL CONTRACTORS LTD

WATER HISTORY:

DATE INSTALLED: JUNE 2007

INSTALLED BY: WESTERN INDUSTRIAL CONTRACTORS LTD

STORM HISTORY:

DATE INSTALLED: JUNE 2007

INSTALLED BY: WESTERN INDUSTRIAL CONTRACTORS LTD