


Lot Servicing

1190 CENTRAL ST E

PID: 027146014

Lot: PCL E, **Block:** 53, **Plan:** 696, **DL:** 936 (BB276313)

SERVICE	SIZE	MATERIAL	INSTALLED DATE	LOCATION	DETAILS
WATER	UNKNOWN	UNKNOWN	07-Jul-1961	FR NW COR BLD 9.1M W 6.1M S	CONNECTION NUMBER 3064
SANITARY	UNKNOWN	UNKNOWN		6.4M S OF NW COR PL	CONNECTION # 1846

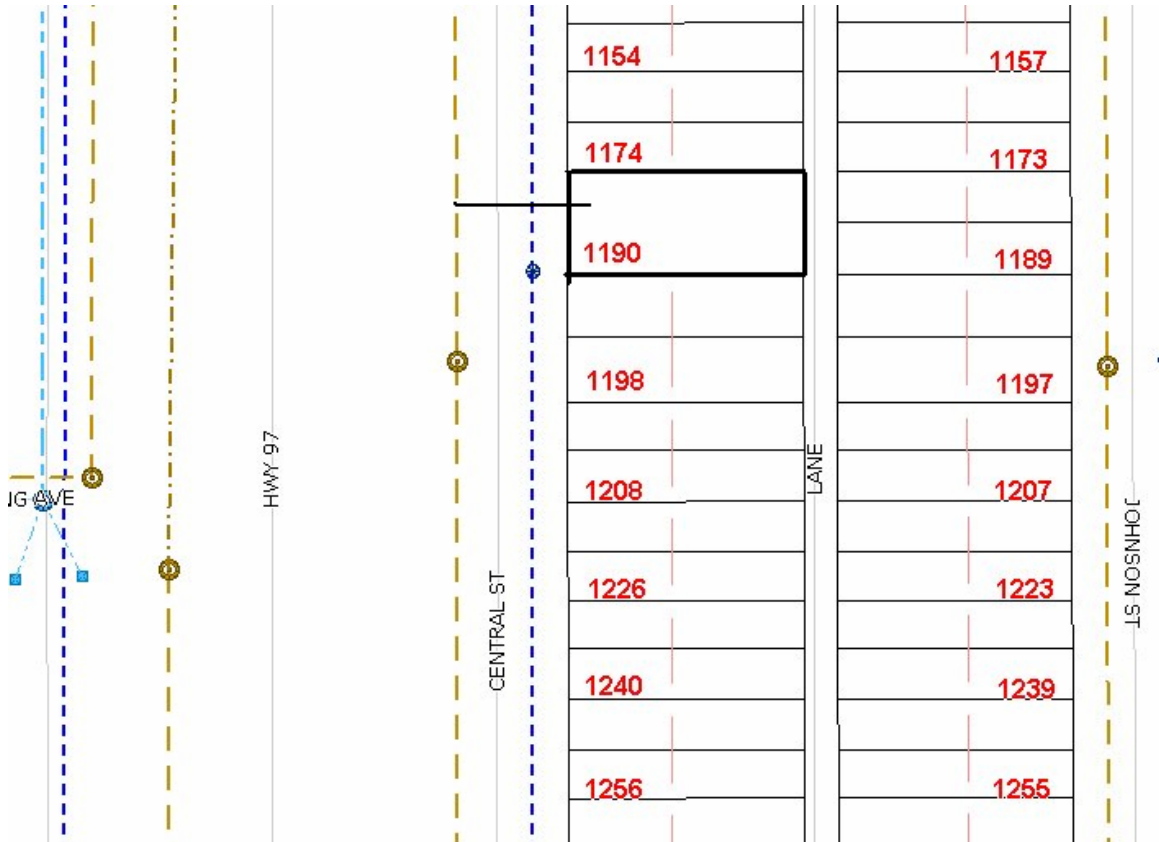

Accuracy not guaranteed unless confirmed by site inspection and/or investigation.
Connection location between main and property line only.