


Lot Servicing

2617 HAZELTON ST

PID: 027159744

Lot: PCL 1, Block: 15, Plan: BCP31695, DL: 933

SERVICE	SIZE	MATERIAL	INSTALLED DATE	LOCATION	DETAILS
WATER	20MM	CU		FR NE COR BLDG 9.3M E 9.3M N	
SANITARY	100MM	PVC	20-Apr-2007	3.0M FR W PL SERVICE RUNS INTO MANHOLE.	CONNECTION # 100656

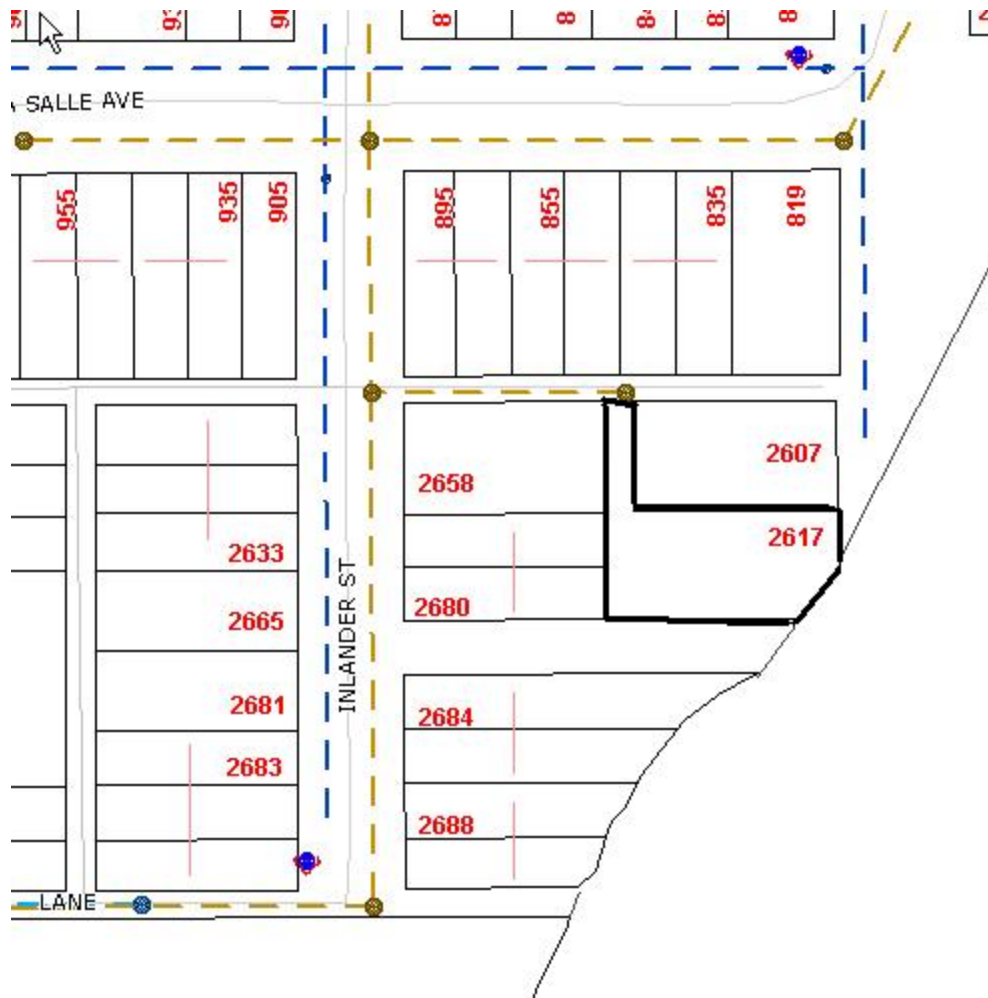

Accuracy not guaranteed unless confirmed by site inspection and/or investigation.
Connection location between main and property line only.