


Lot Servicing

4484 GREENWOOD ST
Lot: A, Plan: BCP31988, DL: 2425

PID: 027176665

SERVICE	SIZE	MATERIAL	INSTALLED DATE	LOCATION	DETAILS
WATER	20MM	CU		7.5M E OF W PL	CONNECTION NUMBER MU100741
SANITARY	100MM	PVC		7.3M E OF W PL	CONNECTION # MU100741

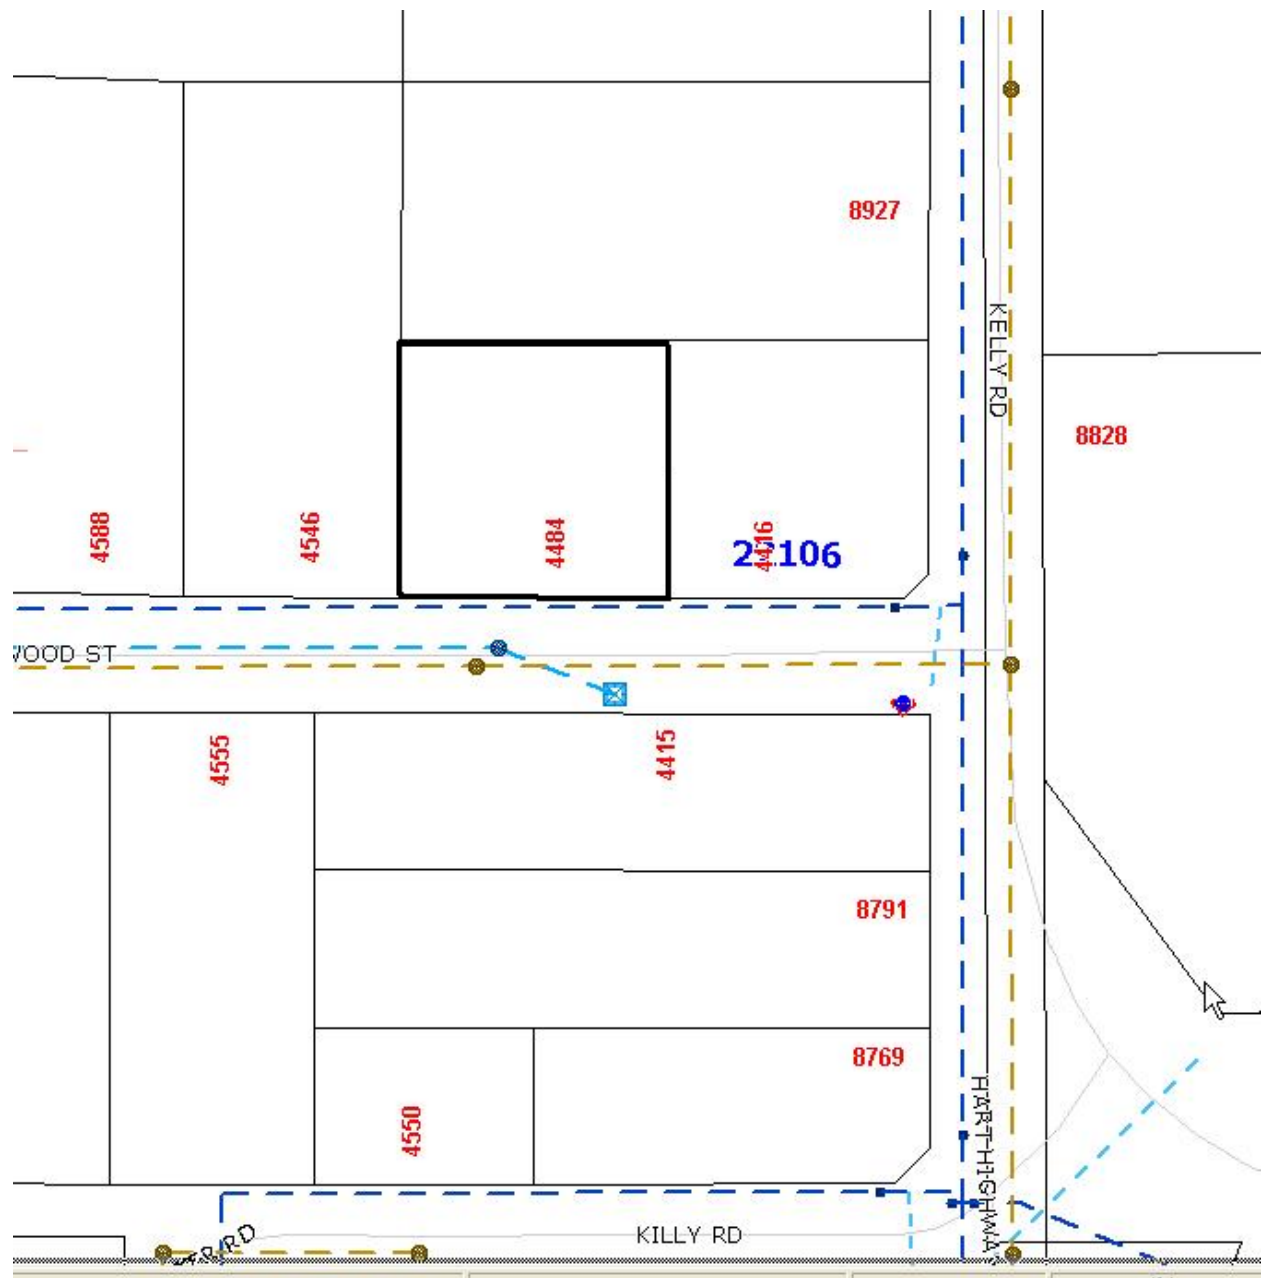

Accuracy not guaranteed unless confirmed by site inspection and/or investigation.
Connection location between main and property line only.