

## Lot Servicing


7930 BUNCE RD

**Lot: 3, Plan: BCP32185, DL: 1599**

PID: 027190935

Servicing located mid-lot

SERVICE	SIZE	MATERIAL	INSTALLED DATE	LOCATION	DETAILS
WATER	20MM	CU	02-Jun-2008	NEW SERVICE	CASH RECEIPT NUMBER 100766
SANITARY	100MM	PVC	02-Jun-2008	NEW SERVICE	CONNECTION # 35953

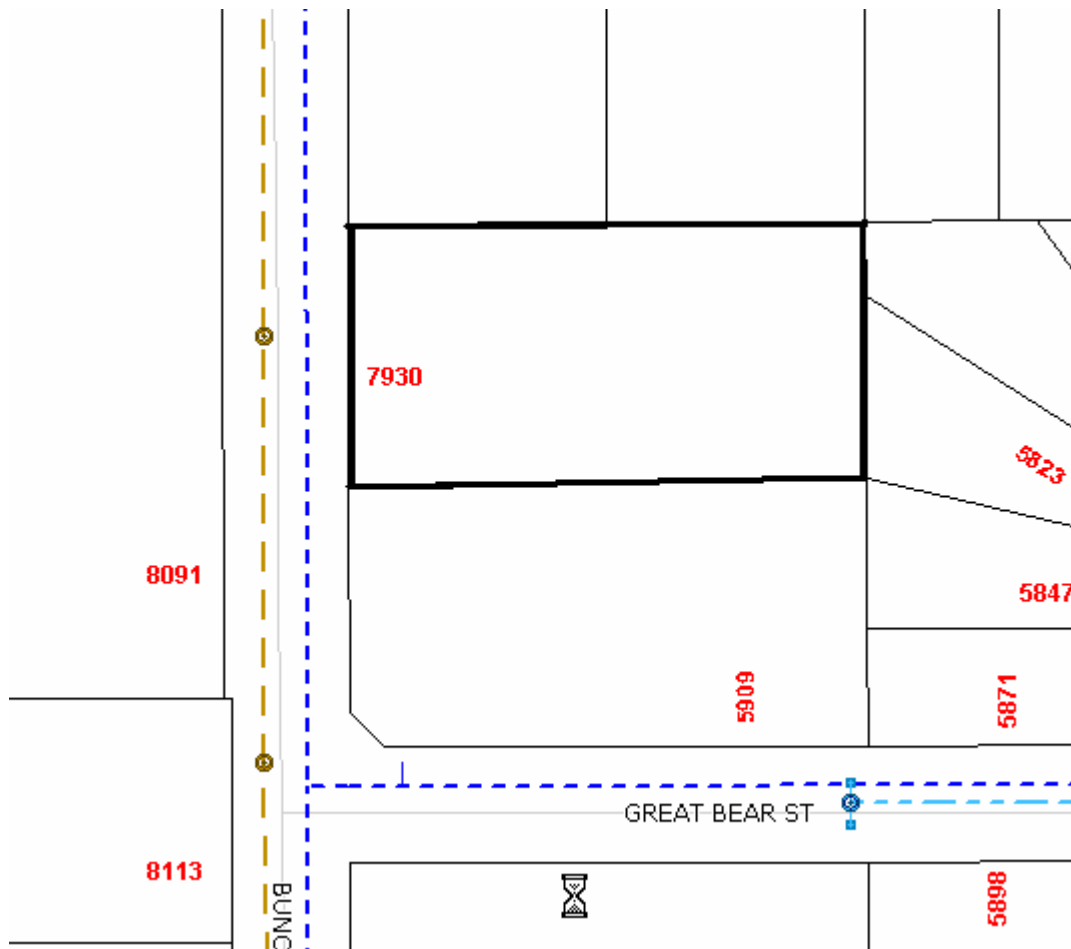

Accuracy not guaranteed unless confirmed by site inspection and/or investigation.  
Connection location between main and property line only.