



City of Prince George History Sheet

PID:	027190943
MU:	100766
WO:	35953

Civic Address: 5909 Great Bear Street

Legal Description: Lot: 4 District Lot: 1599 Plan: BCP32185


Service Type	Diameter (mm)	Material	Invert Elev at main (m)	Invert Elev at property line (m)	Invert Elev at service end (m)	Distance into property (m)	Installation Date
Sanitary	100mm	PVC	-	-	-	-	December 2007
Water	20mm	Copper	-	-	-	-	December 2007
Storm	N/A	N/A	-	-	-	-	

Service Connection Location	Sanitary (m)	Storm (m)
100MM Sanitary service connected to San MH 4772	-	
Distance from downstream Stm MH - towards upstream Stm MH -		

Power	Size	Communications	Size	Cable	Size	Gas	Size
BC Hydro	-	Telus	-	Shaw	-	FortisBC	-
Overhead Service		Overhead Service		Overhead Service			

Installed by: City of Prince George forces	Survey Date: -
Comments:	

NOT TO SCALE The information contained herein is for internal use only.
Not to be relied on unless confirmed by site inspection and/or investigation.

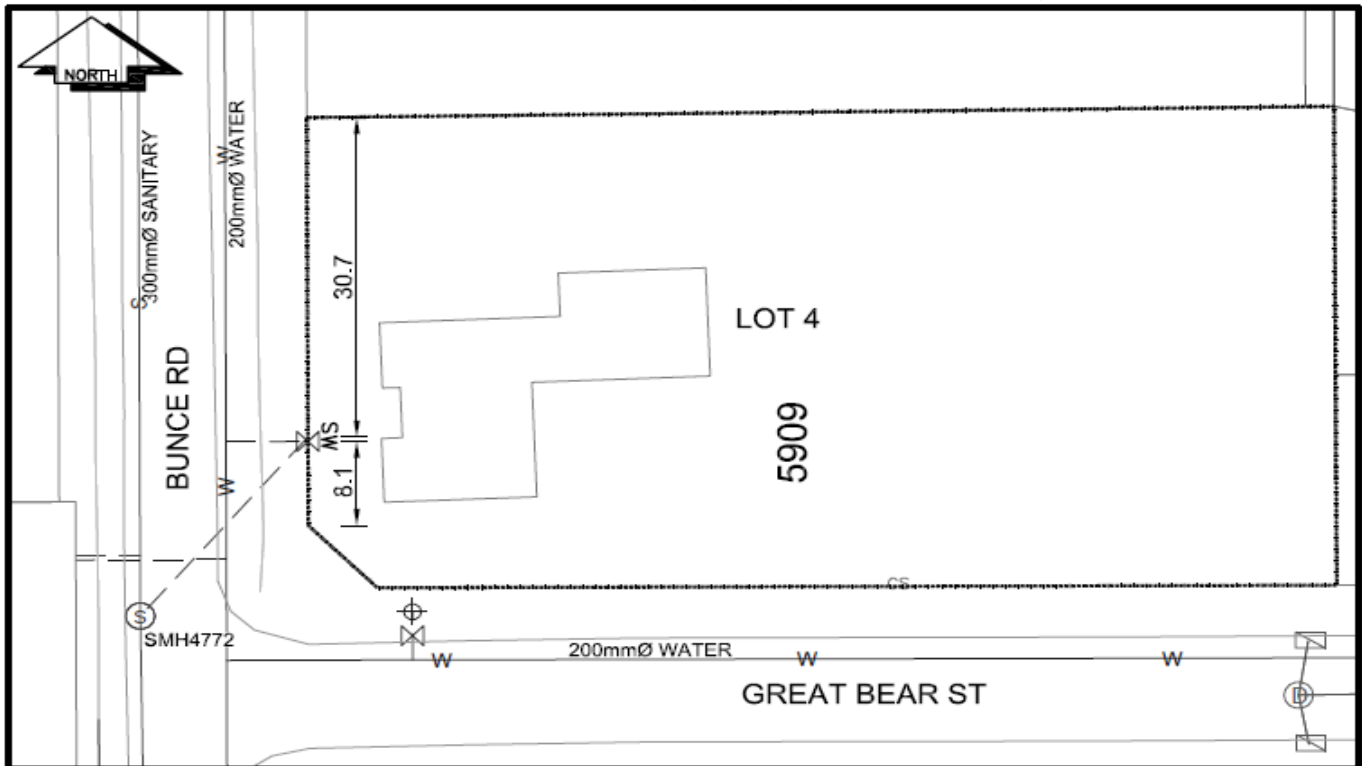

LEGEND:	CS ^o CURB STOP	--- W WATER SERVICE	--- S SANITARY SERVICE	--- G GAS	--- STORM SERVICE
	CO ^o CLEAN OUT				

NOT TO SCALE