


Lot Servicing

2113 QUINCE ST 2117 QUINCE ST
Lot: **A**, Block: **5**, Plan: **796**, DL: **932**

PID: 027217914

SERVICE	SIZE	MATERIAL	INSTALLED DATE	LOCATION	DETAILS
WATER	20MM	CU		FR NE COR BLD 7.3M E 6.2M S	
WATER	20MM	CU		FR SE COR BLD 7.3M E 5.5M N	
SANITARY	UNKNOWN	UNKNOWN		UNKNOWN	
SANITARY	UNKNOWN	UNKNOWN		UNKNOWN	

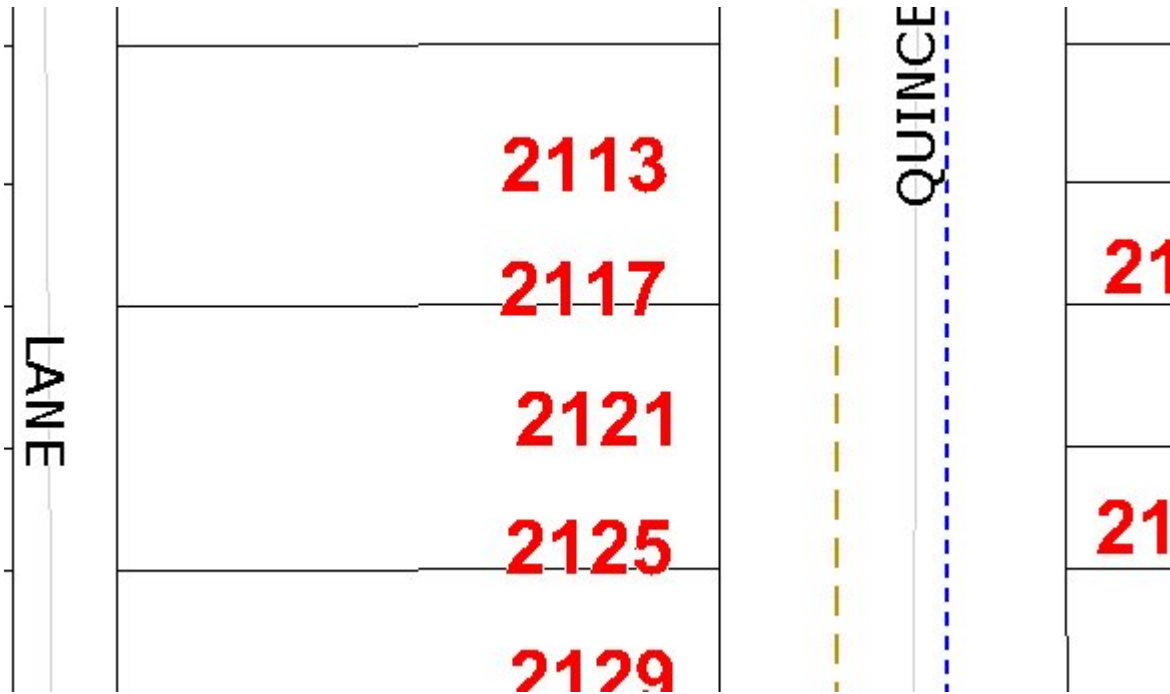

Accuracy not guaranteed unless confirmed by site inspection and/or investigation.
Connection location between main and property line only.