


## Lot Servicing

1451 MILBURN AVE 1455 MILBURN AVE  
Lot: PCL 2, Plan: 22118, DL: 932

PID: 027217957

SERVICE	SIZE	MATERIAL	INSTALLED DATE	LOCATION	DETAILS
WATER	20MM	CU		(1451) FR NE COR BLD 14.8M N 7.2M W	CASH RECEIPT NUMBER 0375
WATER	20MM	CU		(1455) FR NW COR BLD 14.8M N 6.6M E	CONNECTION NUMBER 9629
SANITARY	100MM	AC		(1451) 8.229M W OF NE COR PL	CONNECTION # 9628
SANITARY	100MM	AC		(1455) 8.229M E OF NW COR PL	CONNECTION # 9629

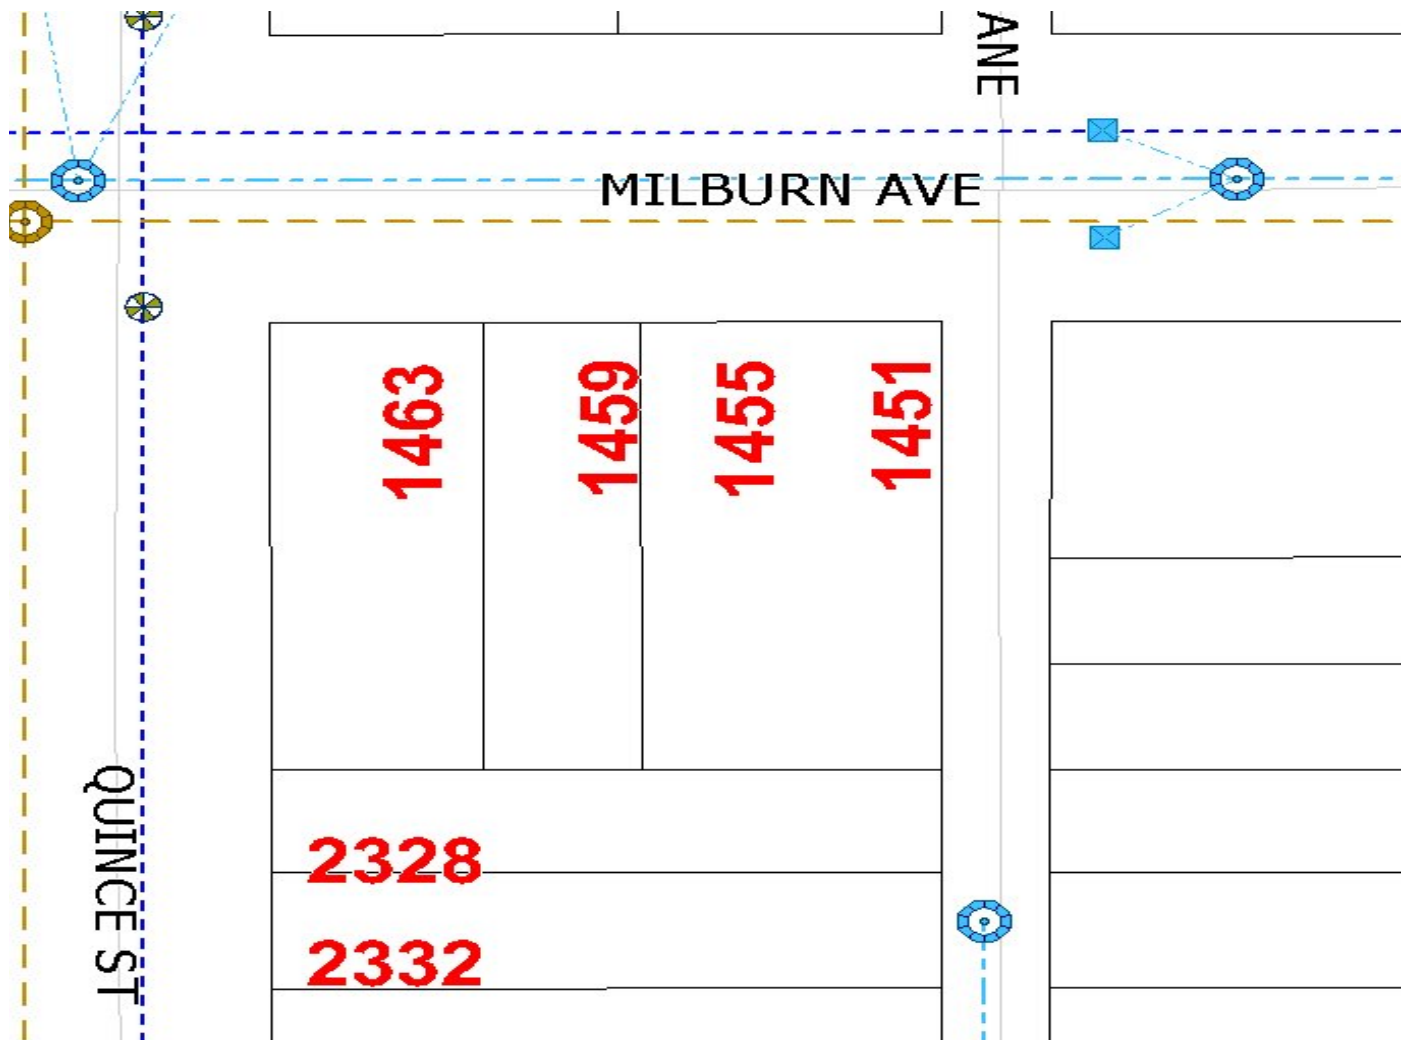

Accuracy not guaranteed unless confirmed by site inspection and/or investigation.  
Connection location between main and property line only.