


Lot Servicing

2121 QUINCE ST 2125 QUINCE ST
 Lot: **B**, Block: **5**, Plan: **796**, DL: **932**

PID: 027217965

SERVICE	SIZE	MATERIAL	INSTALLED DATE	LOCATION	DETAILS
WATER	20MM	CU		FR NE COR BLD 10.7M E 5.7M S	CONNECTION NUMBER 9799
WATER	20MM	CU		FR SE COR BLD 10.7M E 5.7M N	
SANITARY	100MM	AC	01-Jan-1975	7.32M S OF NE COR PL	CONNECTION # 9799
SANITARY	100MM	AC	01-Jan-1975	0.3M N OF SE COR PL	CONNECTION # 9799

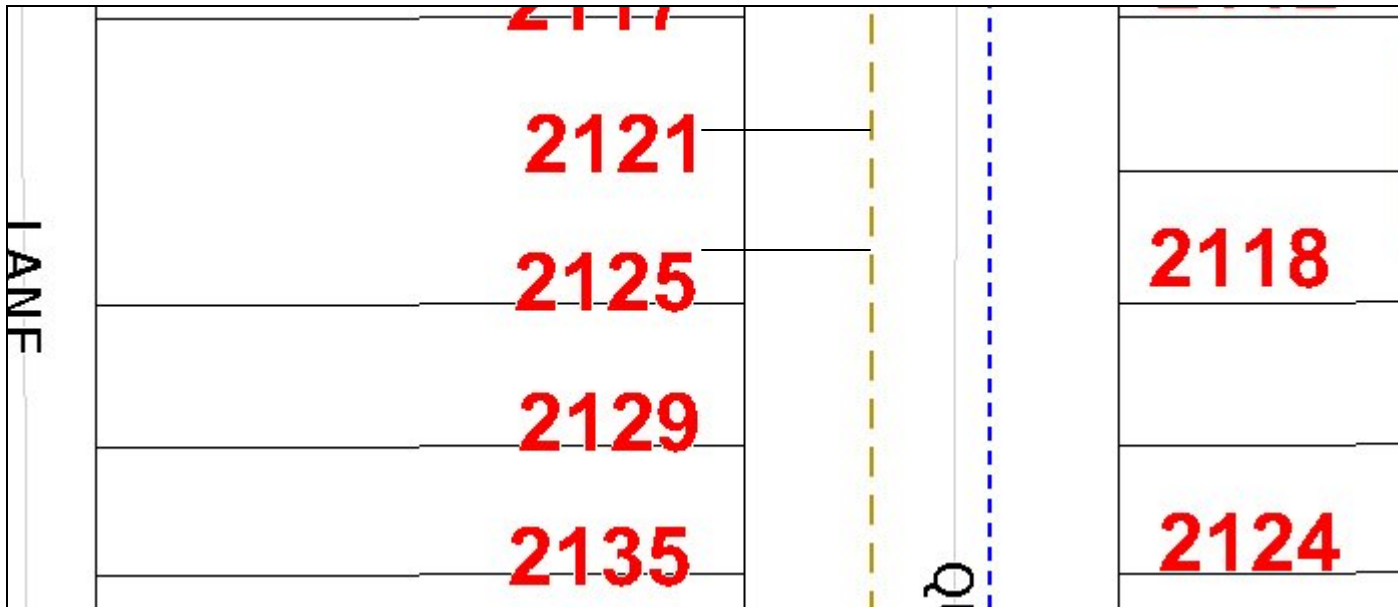

Accuracy not guaranteed unless confirmed by site inspection and/or investigation.
 Connection location between main and property line only.