



City of Prince George History Sheet

PID:	027223388
MU:	100875
WO:	41963-41968

Civic Address: 1656 Queensway

Legal Description: Lot: PCL 1 District Lot: 343 Plan: BCP32516


Service Type	Diameter (mm)	Material	Invert Elev at main (m)	Invert Elev at property line (m)	Invert Elev at service end (m)	Distance into property (m)	Installation Date
Sanitary	150mm	PVC	575.74	-	575.87		August 2008
Water	150mm	PVC	-	-	-	-	August 2008
Storm	250mm	PVC	576.58	576.54	-	-	August 2008

Service Connection Location	Sanitary (m)	Storm (m)
150mm Sanitary service connected to San MH3196	-	
150mm Storm service connect to Stm MH on 17th Ave		

Power	Size	Communications	Size	Cable	Size	Gas	Size
BC Hydro	-	Telus	-	Shaw	-	FortisBC	-
Overhead Service		Overhead Service		Overhead Service			

Installed by:	City of Prince George forces	Survey Date:	-
Comments:	Existing water, sanitary storm disconnected and abandoned		

NOT TO SCALE The information contained herein is for internal use only.
Not to be relied on unless confirmed by site inspection and/or investigation.

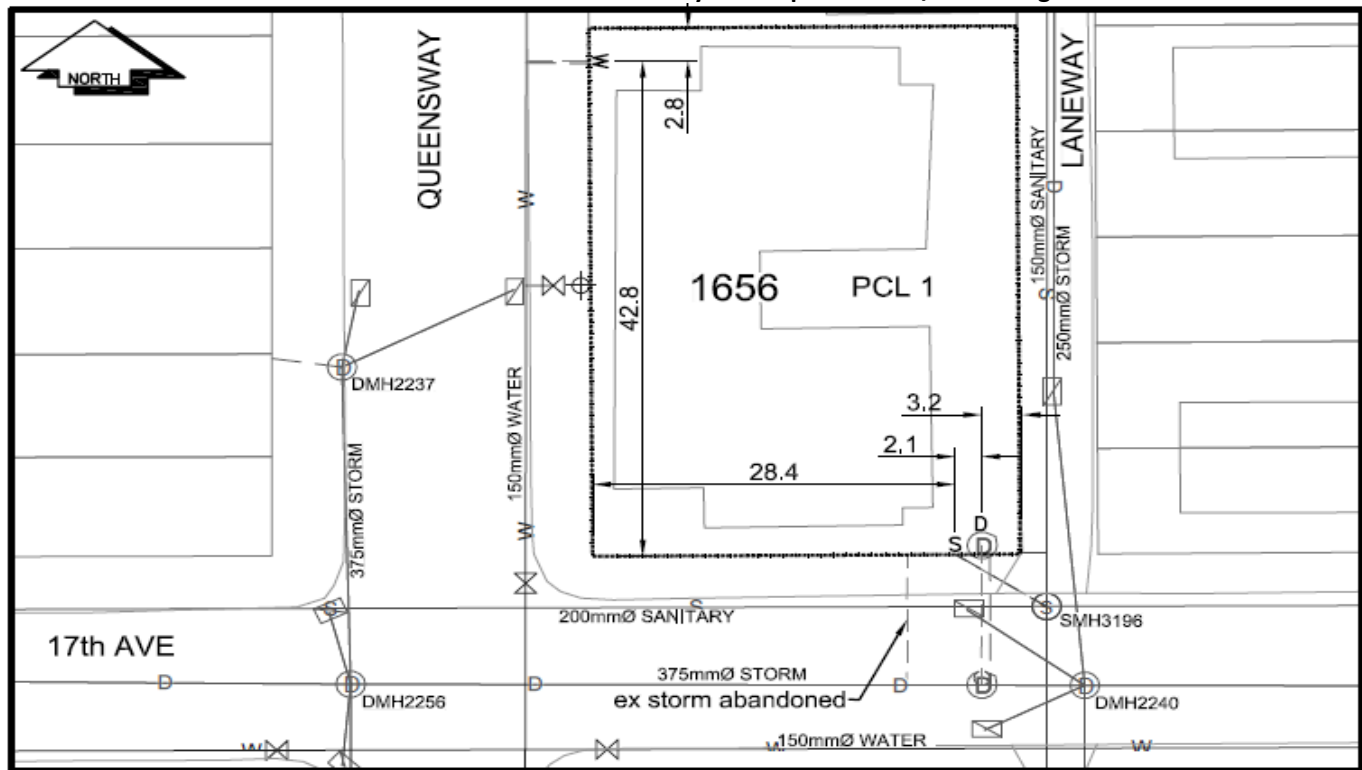

CS ^o CURB STOP	--- WATER SERVICE	--- STORM SERVICE
CO ^o CLEAN OUT	--- SANITARY SERVICE	--- GAS
⊗ WATER VALVE	⊗ FIRE HYDRANT	--- ENCUMBRANCE

NOT TO SCALE