



City of Prince George History Sheet

PID:	027271412
MU:	100806
WO:	42581

Civic Address: 1462 20th Ave
1488 20th Ave

Legal Description: Lot: A District Lot: 343 Plan: BCP33260


Service Type	Diameter (mm)	Material	Invert Elev at main (m)	Invert Elev at property line (m)	Invert Elev at service end (m)	Distance into property (m)	Installation Date
Sanitary	300mm	PVC	574.60	574.63	-	4.80	September 2008
Water (east)	200mm	PVC	-	-	-	-	November 2009
Water (west)	200mm	PVC	-	-	-	-	November 2009
Storm	375mm	PVC	573.36	573.39	-	-	September 2008

Service Connection Location	Sanitary (m)	Storm (m)
300mm Sanitary service connected to San MH 3292	-	
375 Storm service connected to Stm MH 2541		

Power	Size	Communications	Size	Cable	Size	Gas	Size
BC Hydro	-	Telus	-	Shaw	-	FortisBC	-
Underground Service		Underground Service		Underground Service			

Installed by:	City of Prince George forces	Survey Date:	-
Comments:			

NOT TO SCALE The information contained herein is for internal use only.
Not to be relied on unless confirmed by site inspection and/or investigation.

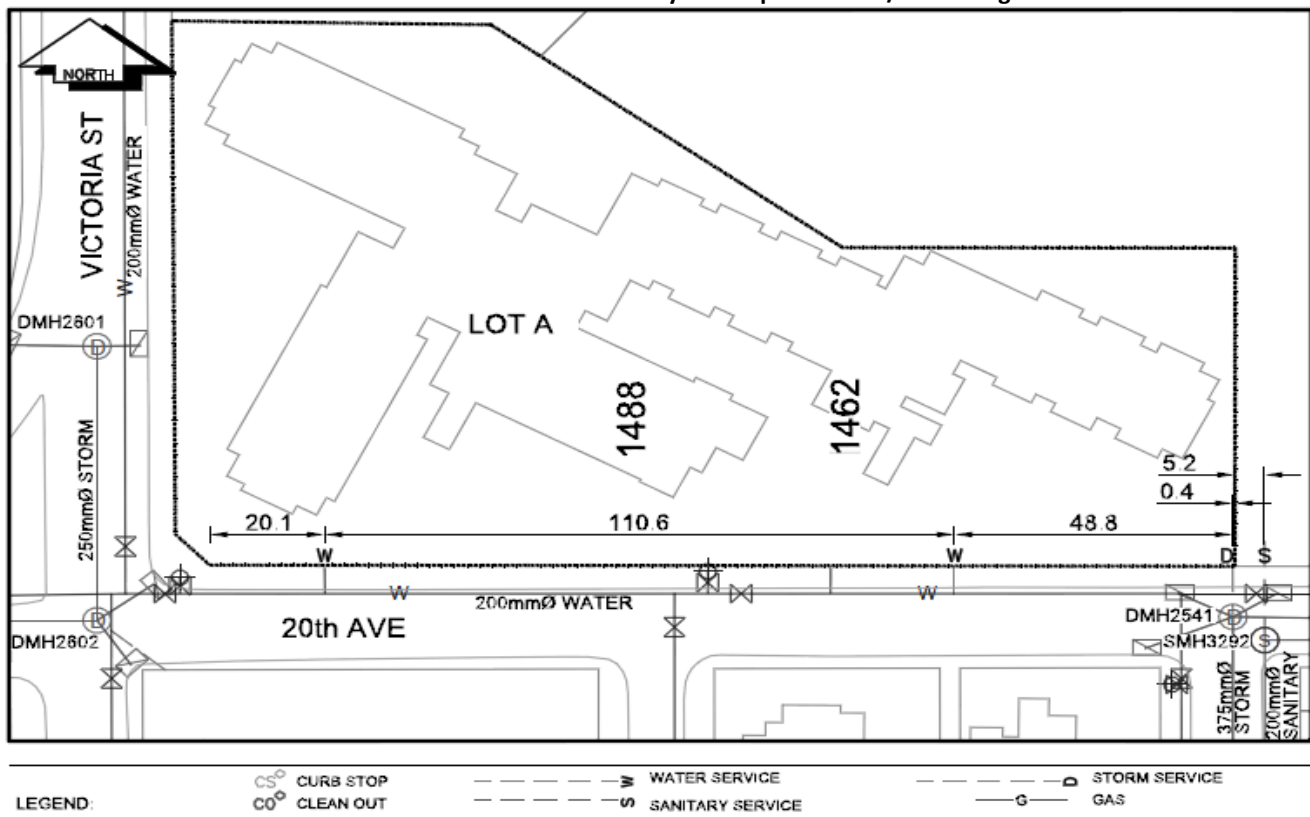

NOT TO SCALE