


Lot Servicing

108 BEDFORD PL
Lot: B, Plan: BCP33339, DL: 343

PID: 027297314

SERVICE	SIZE	MATERIAL	INSTALLED DATE	LOCATION	DETAILS
WATER	20MM	CU		NO LOCATION	
SANITARY	100MM	PVC		IN FR SAN MH # 393902	CUT @ P/L @ DATE OF INSTALLATION 1.420M

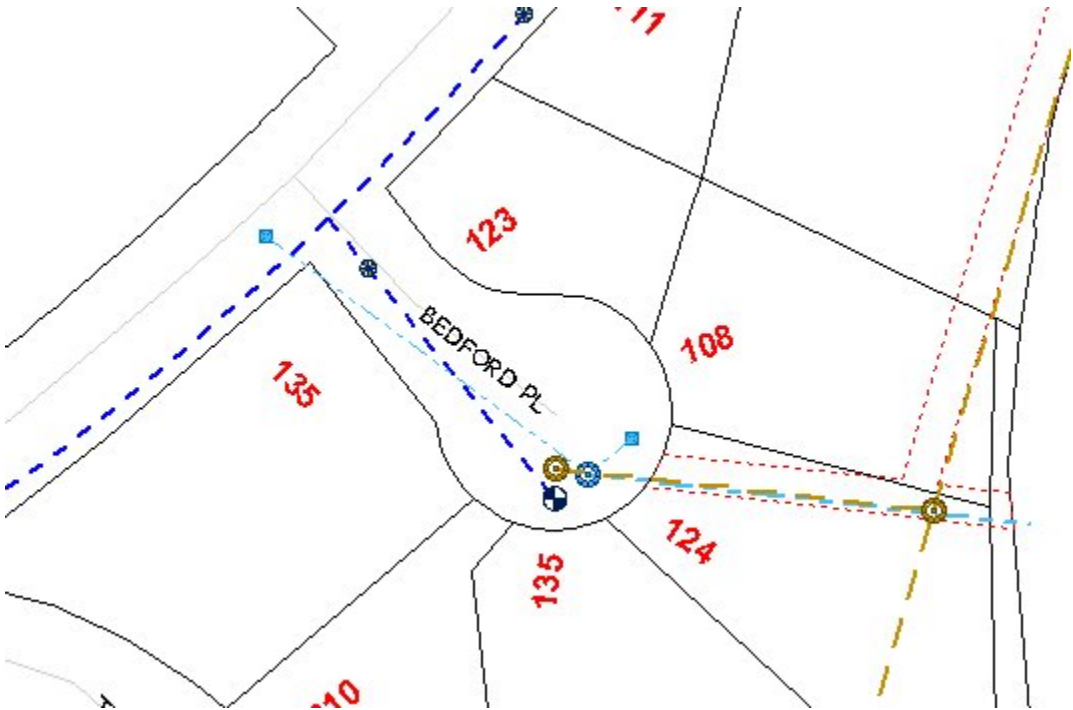

Accuracy not guaranteed unless confirmed by site inspection and/or investigation.
Connection location between main and property line only.