


## Lot Servicing

**655 IRWIN ST**

**pid: 027311970**

Lot: **PCL A**, Block: **24**, Plan: **752**, DL: **937**

SERVICE	SIZE	MATERIAL	INSTALLED DATE	LOCATION	DETAILS
WATER	13MM	UNKNOWN		15.240M N OF SE COR PL	CONNECTION NUMBER 982
SANITARY	UNKNOWN	UNKNOWN		0.304M N OF SE COR PL	CONNECTION # 1859

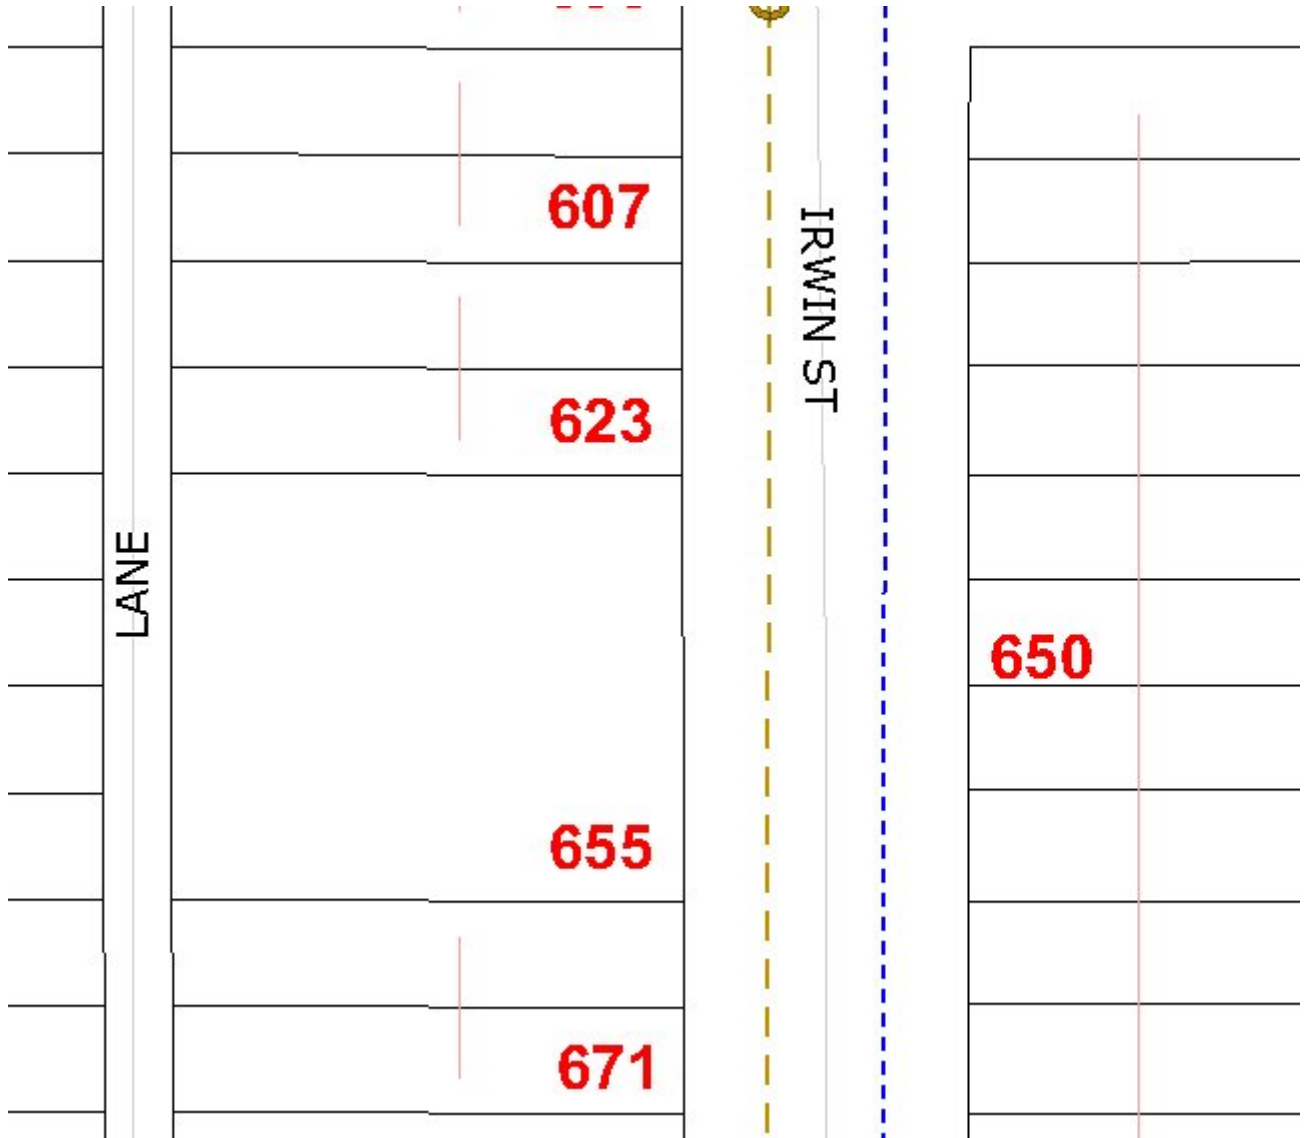

Accuracy not guaranteed unless confirmed by site inspection and/or investigation.  
Connection location between main and property line only.