


Lot Servicing

1467 MILBURN AVE 1471 MILBURN AVE
Lot: PCL 3, Plan: 22118, DL: 932 (BB311206)

PID: 027324079

SERVICE	SIZE	MATERIAL	INSTALLED DATE	LOCATION	DETAILS
WATER	20MM	CU	01-Jan-1975	(1467) 14.9M S OF SE COR BLD 6.4M W	CONNECTION NUMBER 9622
WATER	UNKNOWN	UNKNOWN		(1467) 14.9M S OF SW COR BLD 6.7M E	
SANITARY	100MM	AC		(1467) 0.3M E OF NW COR PL	
SANITARY	100MM	AC		(1471) 0.3M W OF NE COR PL	CLEANOUT 8.4M E OF W PL

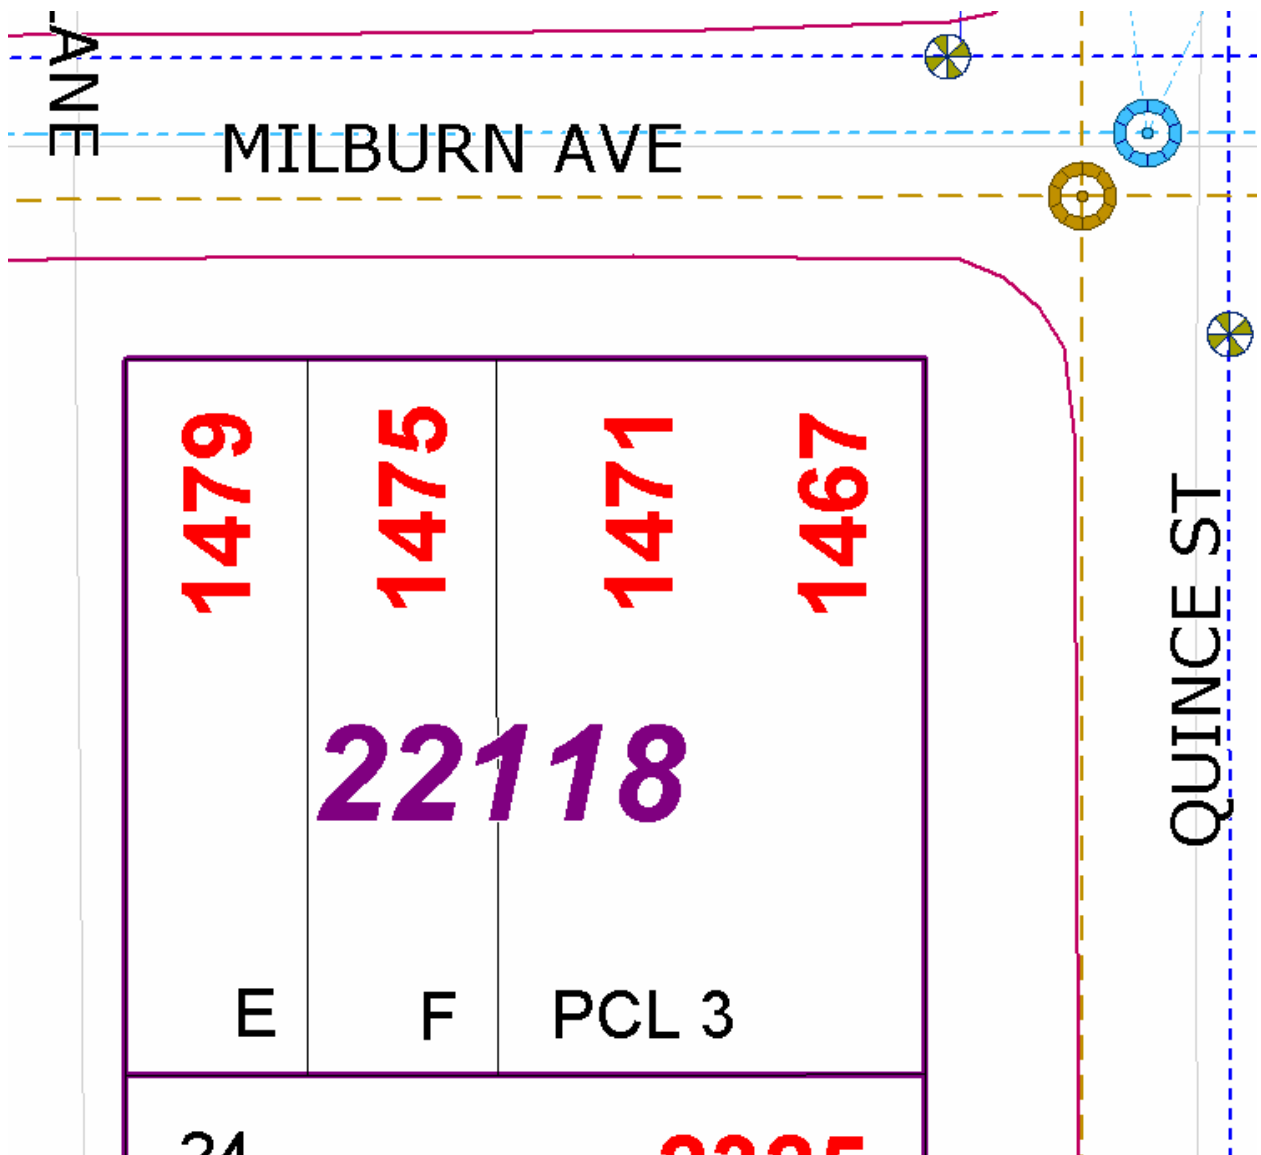

Accuracy not guaranteed unless confirmed by site inspection and/or investigation.
Connection location between main and property line only.