


### Lot Servicing

1656 BIRCH ST

PID: 027326284

**Lot:** PCL C, **Block:** 249, **Plan:** 1268, **DL:** 343 (BB311720)

SERVICE	SIZE	MATERIAL	INSTALLED DATE	LOCATION	DETAILS
WATER	20MM	CU	01-Jan-1954	FR SW COR BLD 9.5M W 3.8M N	CONNECTION NUMBER 409
SANITARY	UNKNOWN	UNKNOWN		NO LOCATION	

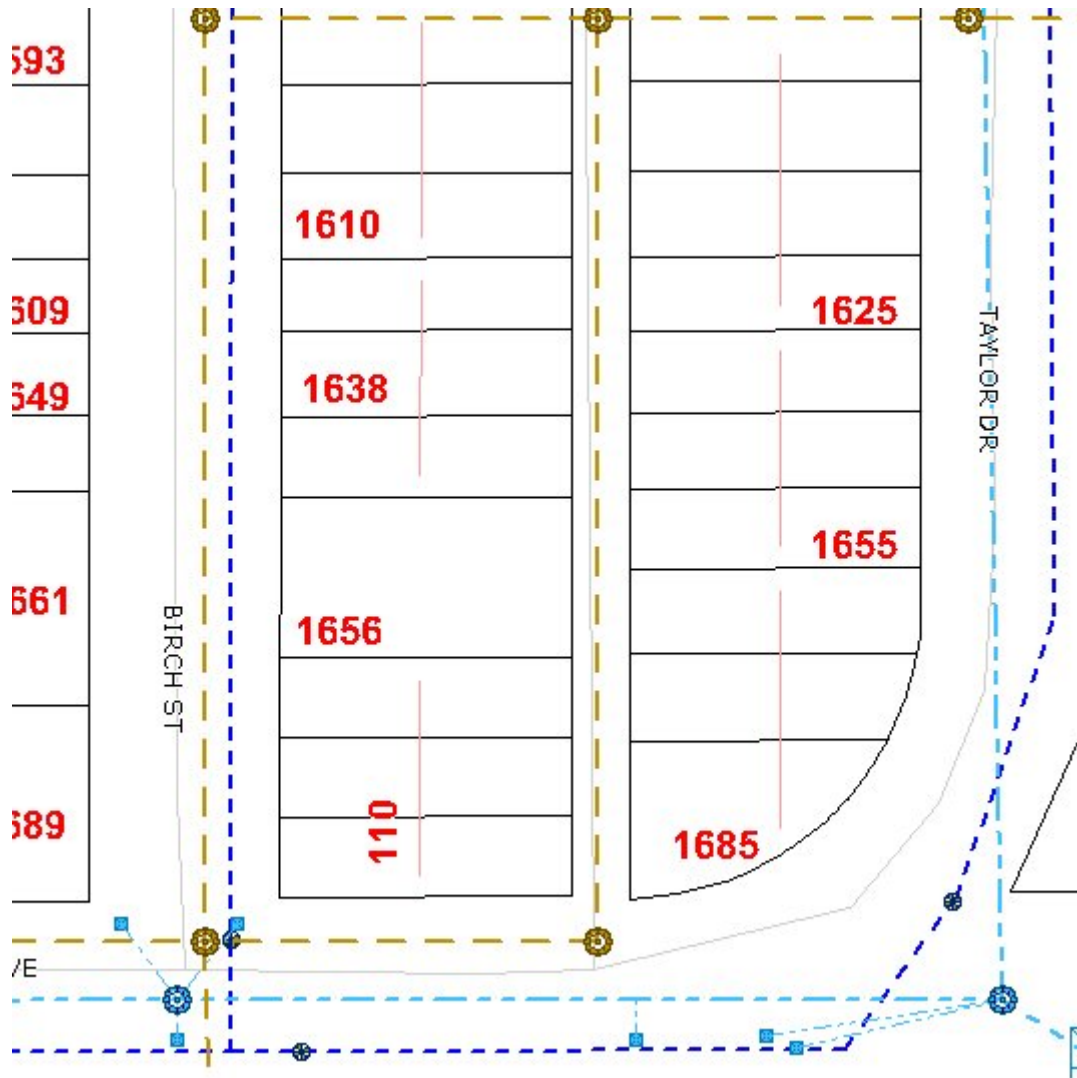

Accuracy not guaranteed unless confirmed by site inspection and/or investigation.  
Connection location between main and property line only.