


## Lot Servicing

501 RICHARD RD

PID: 027335178

**Lot: 1, Plan: BCP33956, DL: 1574**

SERVICE	SIZE	MATERIAL	INSTALLED DATE	LOCATION	DETAILS
WATER	UNKNOWN	UNKNOWN		NO LOCATION	
WATER	20MM	CU		IN FR SERVICE ON MCALONEY RD.	
SANITARY	100MM	PVC		FR SAN MH # HN228	RECEIPT # 7714
SANITARY	100MM	PVC		IN FR SAN MH # 453109	

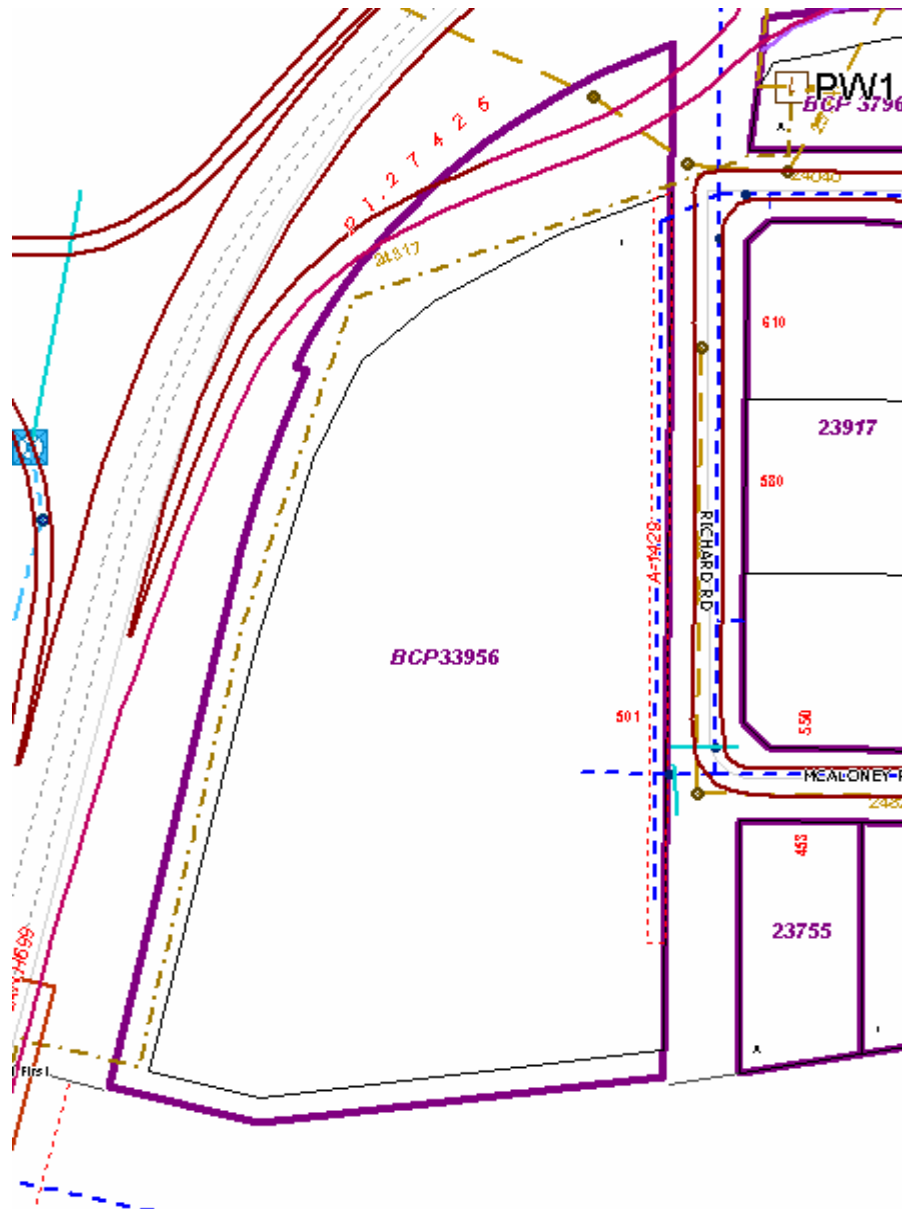

Accuracy not guaranteed unless confirmed by site inspection and/or investigation.  
Connection location between main and property line only.