


## Lot Servicing

220 FORT ST

PID: 027340929

**Lot:** PCL 1, **Plan:** BCP33992, **DL:** 343

| SERVICE  | SIZE  | MATERIAL | INSTALLED DATE | LOCATION                                     | DETAILS                    |
|----------|-------|----------|----------------|--|----------------------------|
| WATER    | 40MM  | CU       | 30-Aug-2006    | LOT 16 - 6.7M N AND 5.6M E OF NW CORNER BLDG | CASH RECEIPT NUMBER 100528 |
| SANITARY | 100MM | PVC      | 30-Aug-2006    | LOT 16 - 2.7M N AND 6.3M E OF NW CORNER BLDG | RECEIPT # 100528           |

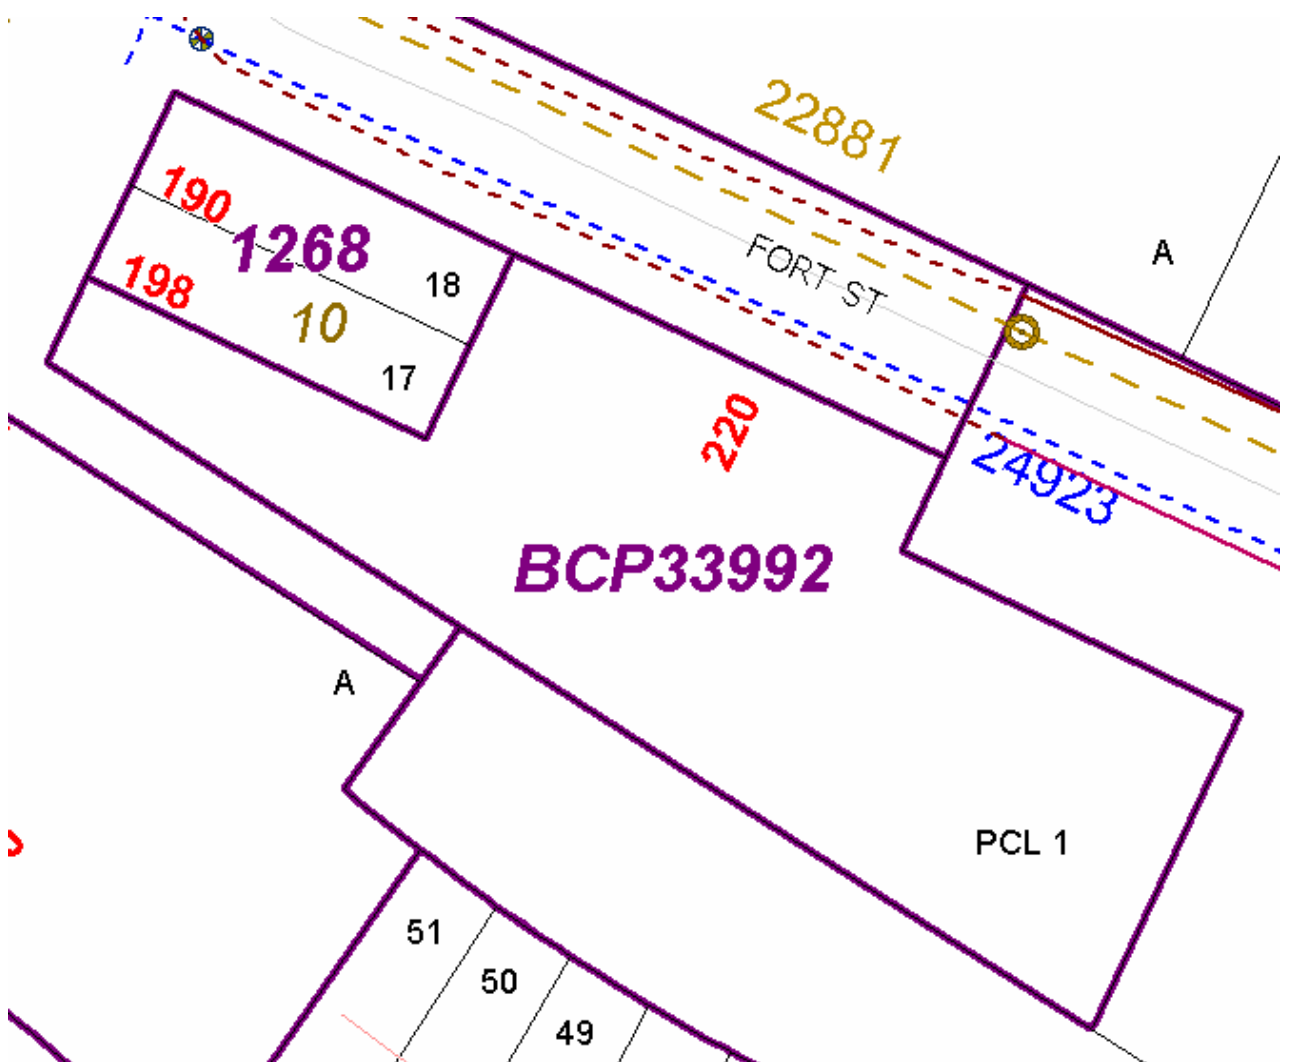

Accuracy not guaranteed unless confirmed by site inspection and/or investigation.  
Connection location between main and property line only.