


## Lot Servicing

1040 HERITAGE CRES  
Lot: A, Plan: BCP34514, DL: 2608

PID: 027370941

SERVICE	SIZE	MATERIAL	INSTALLED DATE	LOCATION	DETAILS
WATER	19MM	CU		@ SW COR OF LOT	
SANITARY	100MM	PVC		@ NW COR LOT	DIFF OR CUT BELOW @ P/L C-1.93

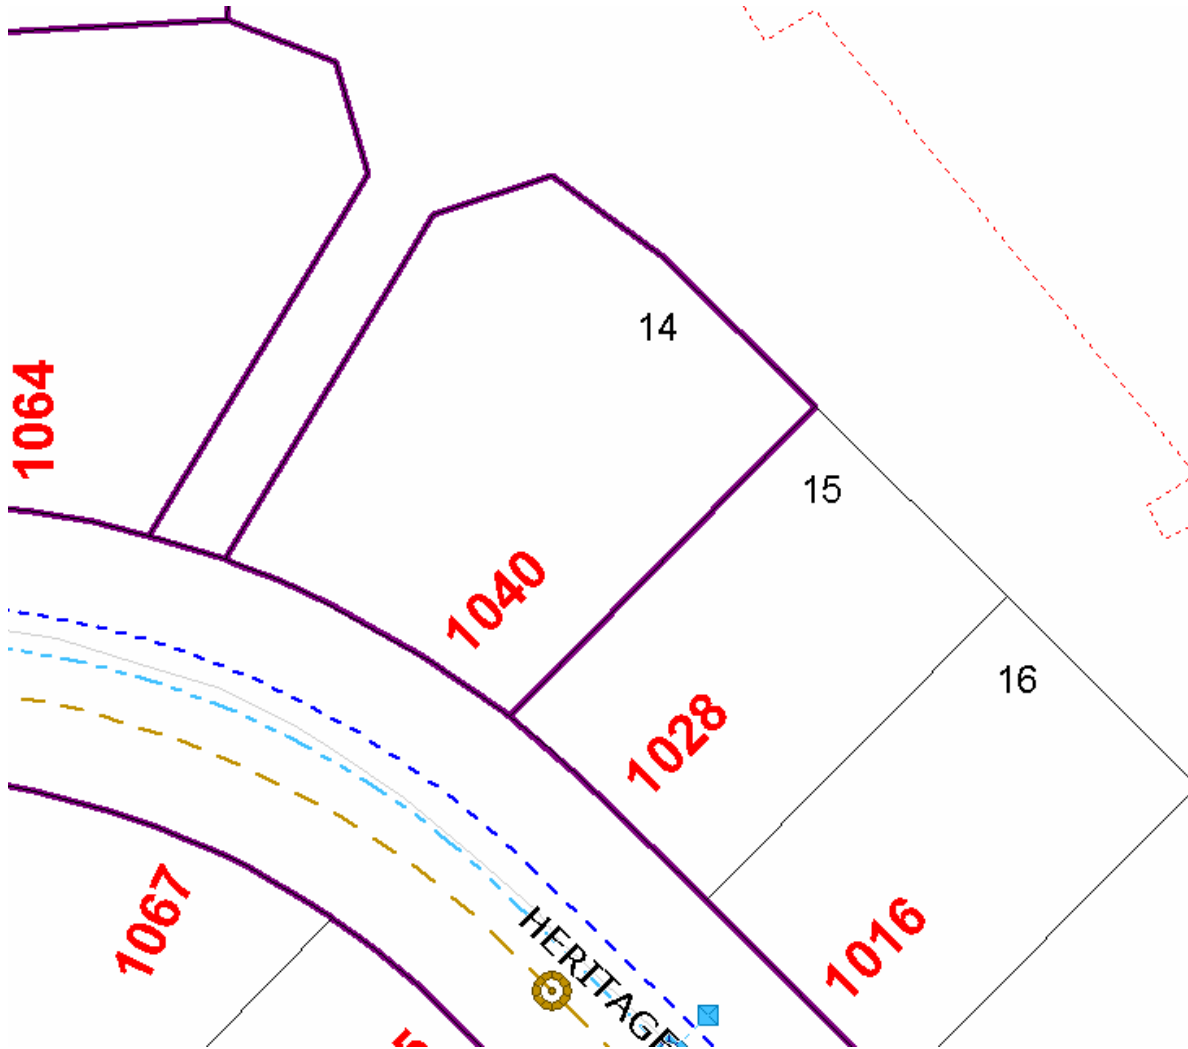

Accuracy not guaranteed unless confirmed by site inspection and/or investigation.  
Connection location between main and property line only.