


Lot Servicing

1064 HERITAGE CRES

PID: 027370968

Lot: A, Plan: BCP34515, DL: 2608

SERVICE	SIZE	MATERIAL	INSTALLED DATE	LOCATION	DETAILS
WATER	19MM	CU		0.3M W OF SE COR PL ; FR SE COR BLD 10.M S	
SANITARY	100MM	PVC		@ SW COR LOT ; FR SW COR BLD 5.3M S 2.0M E	DIFF OR CUT BELOW @ P/L C- 2.20

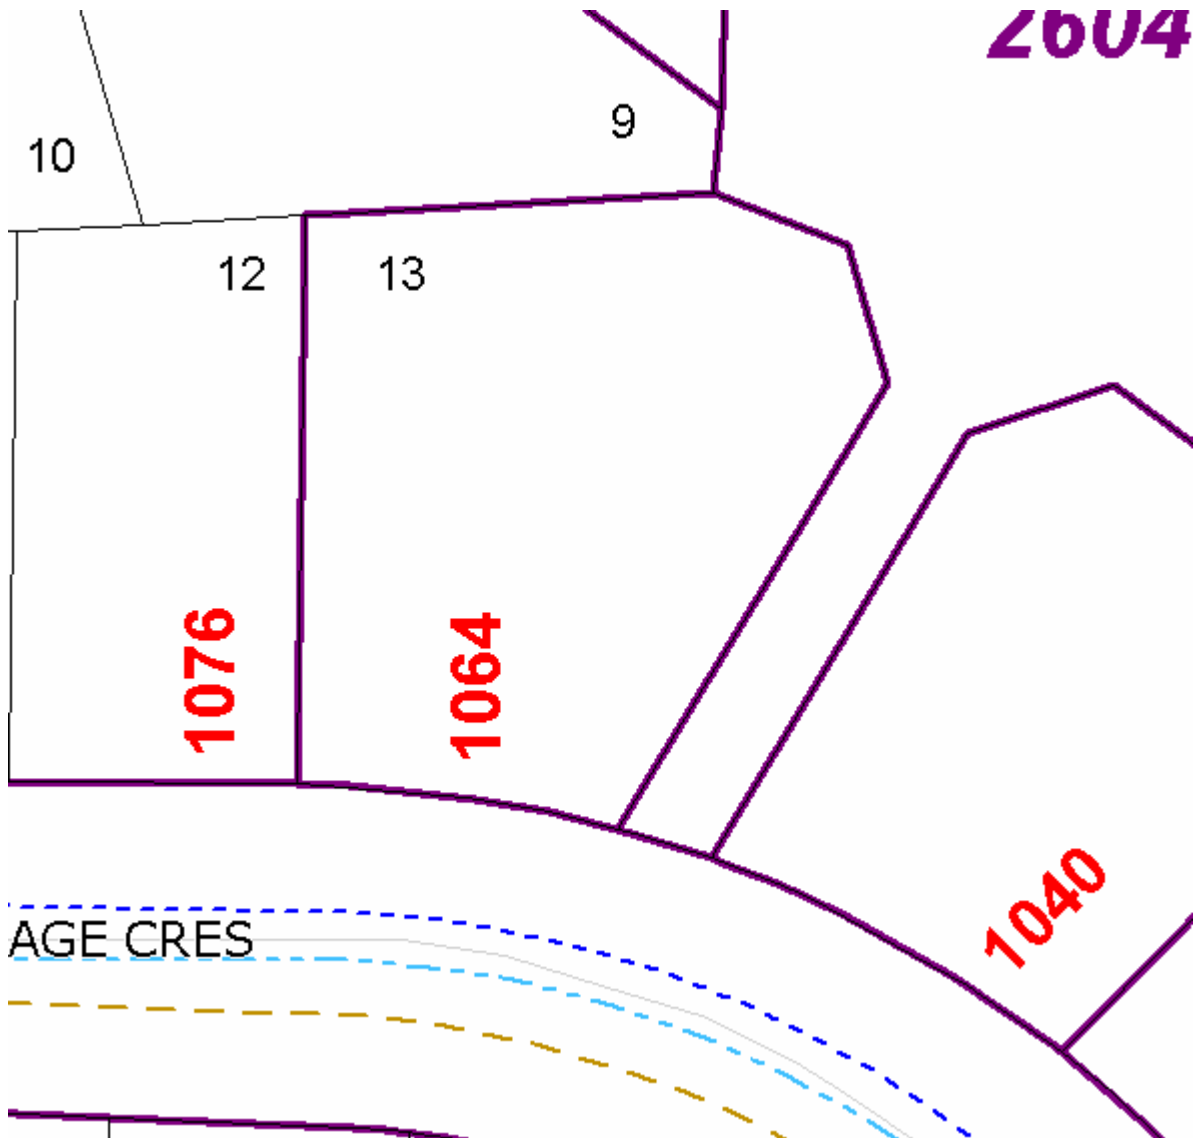

Accuracy not guaranteed unless confirmed by site inspection and/or investigation.
Connection location between main and property line only.