



City of Prince George History Sheet

PID:	027373282
MU:	101126
WO:	55378

Civic Address: 1480, 1484, 1486, 1492 2nd Ave
192, 194, 196, 198 Victoria St

Legal Description: Lot: PCL B Block: 19 (BB628452) District Lot: 343 Plan: 1268


Service Type	Diameter (mm)	Material	Invert Elev at main (m)	Depth of cut at property line (m)	Invert Elev at service end (m)	Distance into property (m)	Installation Date
Sanitary	150mm	Unknown	-	-	-	-	July 1989
Water	100mm	Steel	-	-	-	-	
Storm (Lane)	150mm	PVC	-	-	-	-	October 2010
Storm (2nd Ave)	150mm	Unknown	-	1.22	-	-	June 1979

Service Connection Location				Sanitary (m)	Storm (m)
Sanitary service connected to SMH2711				-	
150mm storm service in laneway connected to MH					
Distance from downstream Stm MH	2200	towards upstream Stm MH	2196		78.39

Power	Size	Communications	Size	Cable	Size	Gas	Size
BC Hydro	-	Telus	-	Shaw	-	FortisBC	-
Overhead Service		Overhead Service		Overhead Service			

Installed by:	City of Prince George forces	Survey Date:	-
Comments:			

NOT TO SCALE The information contained herein is for internal use only.
Not to be relied on unless confirmed by site inspection and/or investigation.

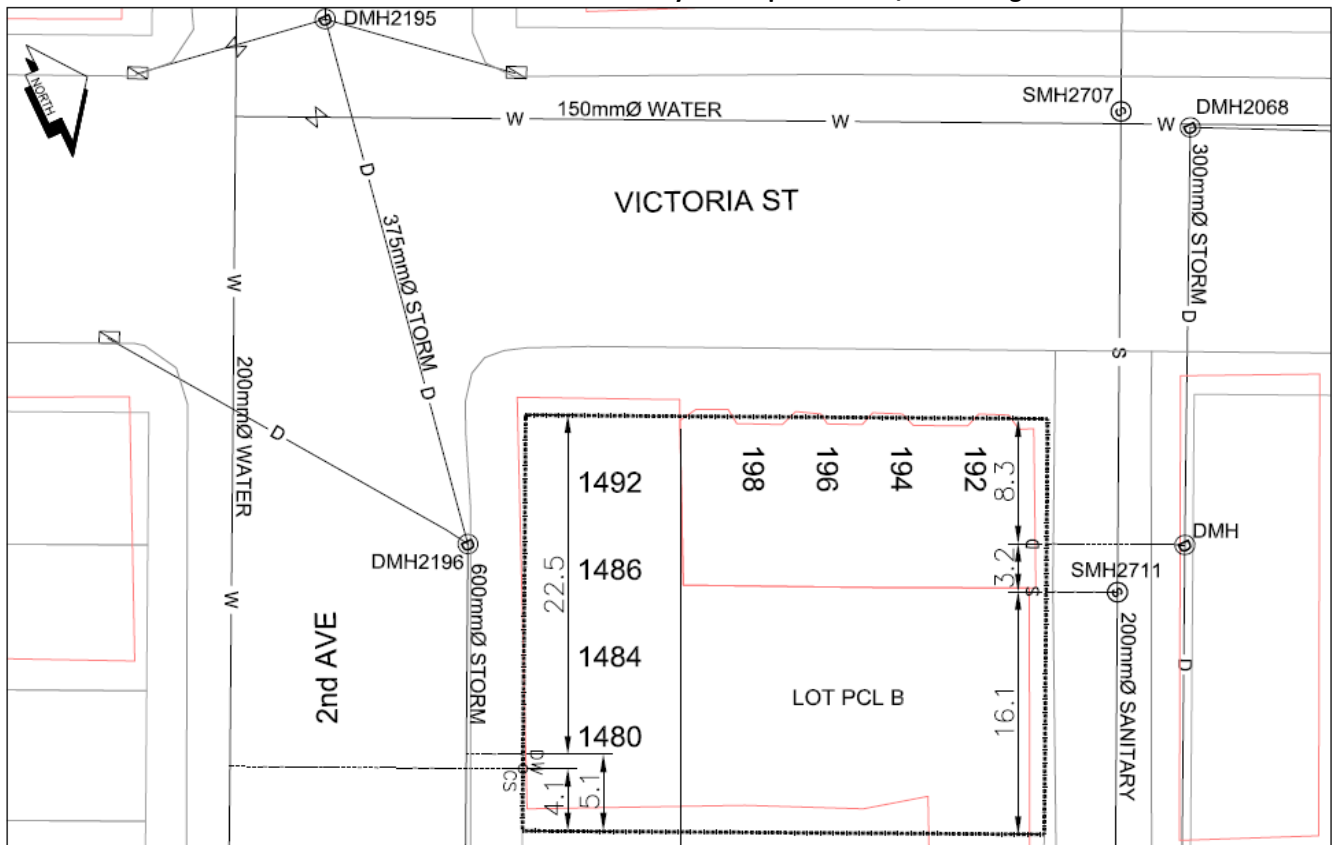

NOT TO SCALE