


Lot Servicing

706 DOUGLAS ST

PID: 027395561

Lot: PCL E, **Block:** 1, **Plan:** 752, **DL:** 937 (BB198988)

SERVICE	SIZE	MATERIAL	INSTALLED DATE	LOCATION	DETAILS
WATER	20MM	CU		FR NW COR BLD 9.14M W 2.4M N	CONNECTION NUMBER 903
SANITARY	UNKNOWN	UNKNOWN		1.828M S OF NW COR PL	CONNECTION # 1946

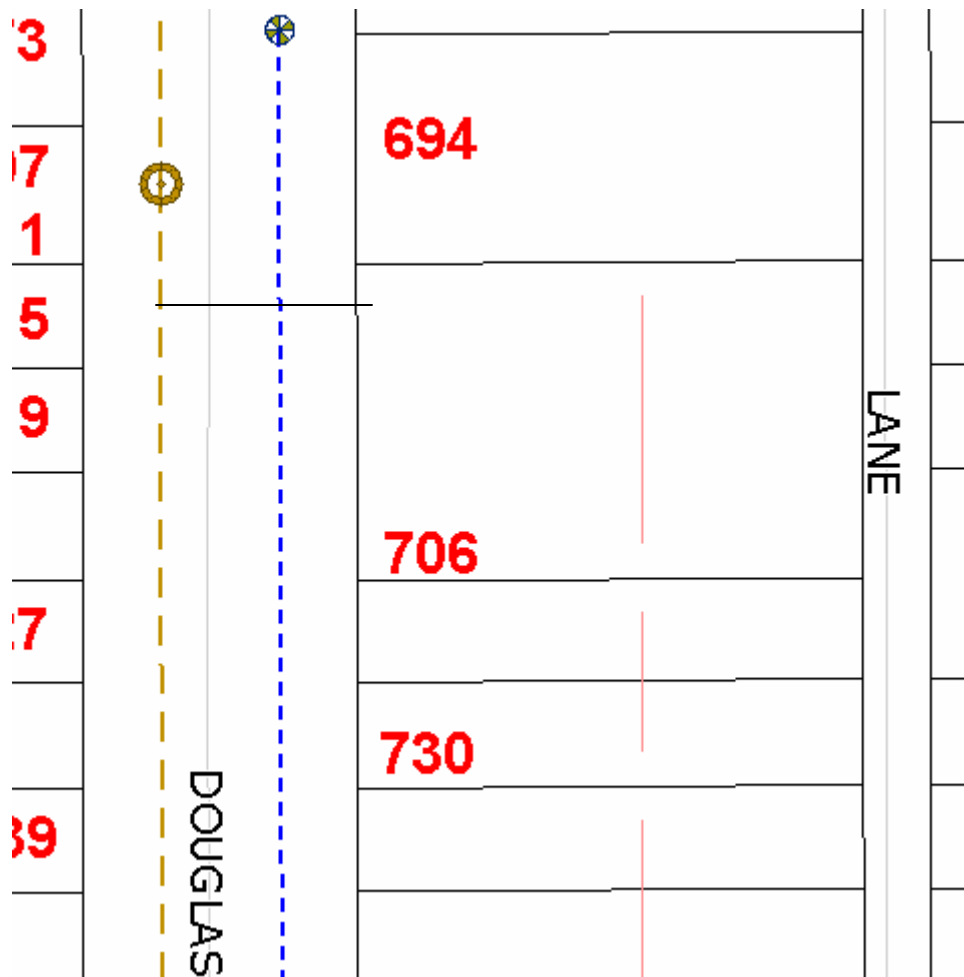

Accuracy not guaranteed unless confirmed by site inspection and/or investigation.
Connection location between main and property line only.