


## Lot Servicing

7002 KELLY RD S

PID: 027425886

**Lot:** PCL A, **Plan:** 11058, **DL:** 4047 (BB207806)

SERVICE	SIZE	MATERIAL	INSTALLED DATE	LOCATION	DETAILS
WATER	20MM	UNKNOWN	01-Jun-1981	FR NW COR PL 0.2M W 14.6M S	THAW WIRE Y
WATER	20MM	UNKNOWN	21-May-1981	FR SW COR PL 0.3M W 9.4M N	CASH RECEIPT NUMBER 018
SANITARY	100MM	UNKNOWN	01-Jun-1981	10.66M S OF N PL	CONNECTION # 15129
SANITARY	100MM	UNKNOWN	01-Jun-1981	10.66M N OF SW COR PL	CONNECTION # 15129

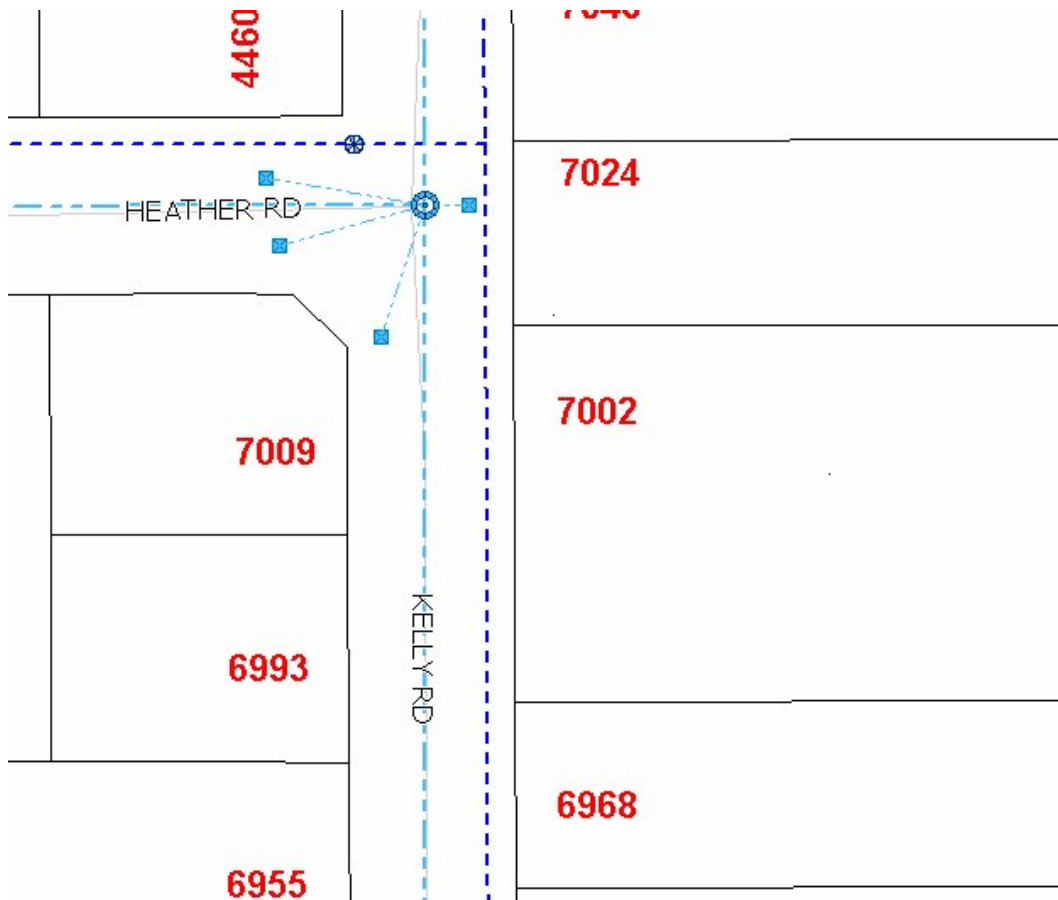

Accuracy not guaranteed unless confirmed by site inspection and/or investigation.  
Connection location between main and property line only.