



City of Prince George History Sheet

PID:	027435270
SD/MU:	
WO:	

Civic Address: 950 Kerry St

Legal Description: Lot: A District Lot: 2507 Plan: EXCEPT PLAN EPP99007


Service Type	Diameter (mm)	Material	Invert Elev at main (m)	Invert Elev at property line (m)	Invert Elev at service end (m)	Distance into property (m)	Installation Date
Sanitary	150mm	AC	-	-	-	-	January 1973
Water	100mm	Unknown	-	-	-	-	January 1973
Storm	250mm	AC	-	-	-	-	January 1972

Service Connection Location				Sanitary (m)	Storm (m)
Distance from downstream San MH	2727	towards upstream San MH	1922	23.43	
Distance from downstream Stm MH	357	towards upstream Stm MH	347		24.76% or

Power	Size	Communications	Size	Cable	Size	Gas	Size
BC Hydro	-	Telus	-	Shaw	-	FortisBC	-
Overhead Service		Overhead Service		Overhead Service			

Installed by:	Survey Date:	-
Comments:		

NOT TO SCALE The information contained herein is for internal use only.
Not to be relied on unless confirmed by site inspection and/or investigation.

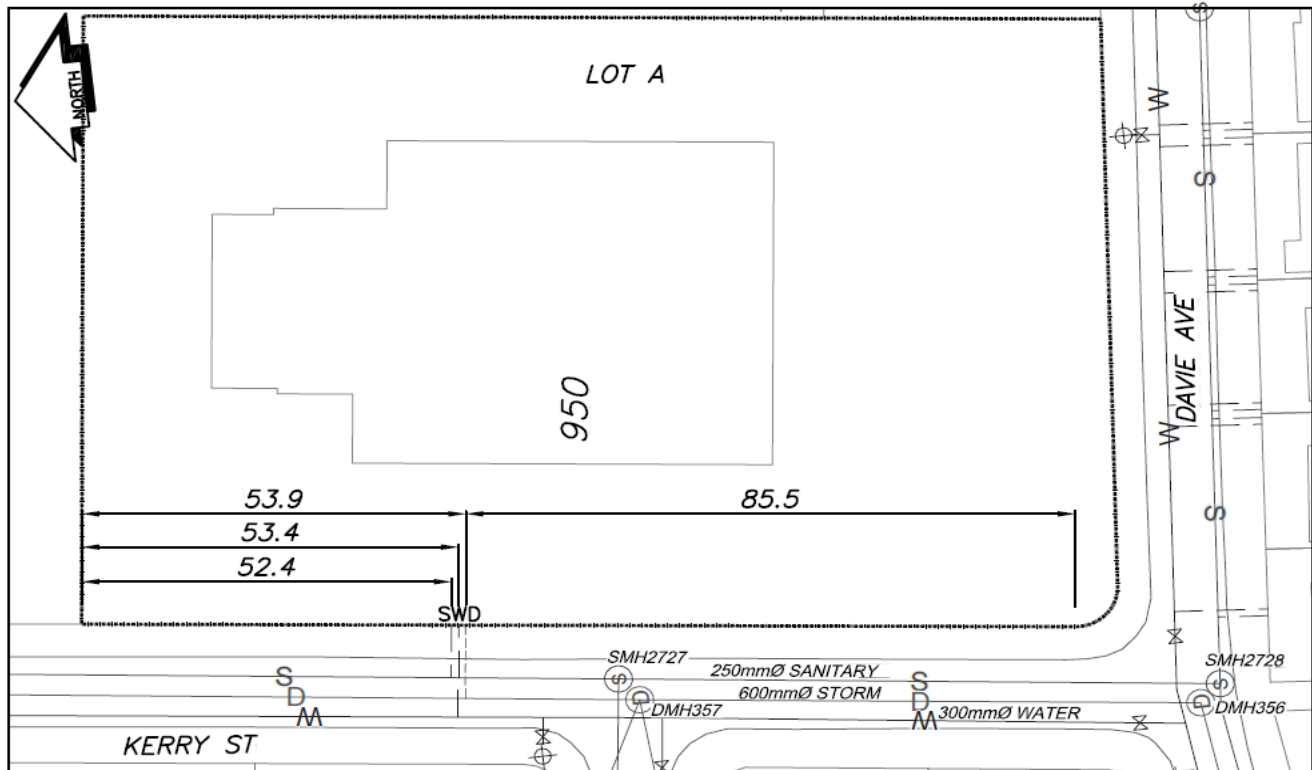

CS ^o CURB STOP	— — — — — WATER SERVICE	— — — — — STORM SERVICE
CO ^o CLEAN OUT	— — — — — SANITARY SERVICE	— G — — — GAS
⊗ WATER VALVE	XXXmmØ SANITARY HYDRANT	— — — — — ENCUMBERANCE

NOT TO SCALE