


Lot Servicing

7610 ST MARK CRES

PID: 027444597

Lot: A, Plan: BCP33952, DL: 754

SERVICE	SIZE	MATERIAL	INSTALLED DATE	LOCATION	DETAILS
WATER	20MM	CU		3.35M W OF E PL	
SANITARY	100MM	PVC		3.048M E OF W PL	
STORM	100MM	PVC		NO LOCATION GIVEN	

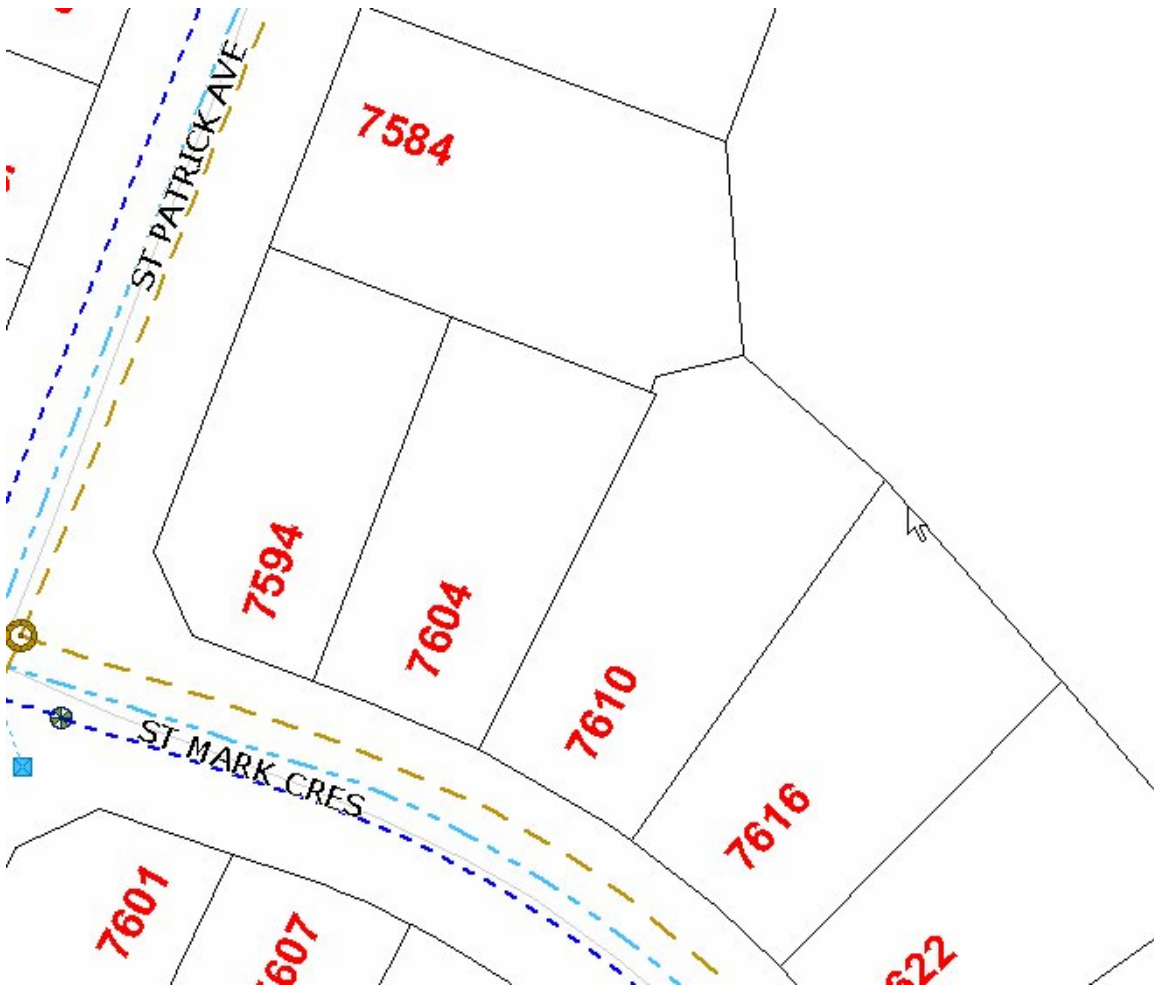

Accuracy not guaranteed unless confirmed by site inspection and/or investigation.
Connection location between main and property line only.