


Lot Servicing

7102 ELK RD
Lot: A, Plan: BCP35582, DL: 1599

PID: 027447464

SERVICE	SIZE	MATERIAL	INSTALLED DATE	LOCATION	DETAILS
WATER	20MM	CU	06-Oct-2008	3.2M N OF S PL	CASH RECEIPT NUMBER 100814
SANITARY	100MM	PVC	06-Oct-2008	4M N OF S PL	CONNECTION # 39788

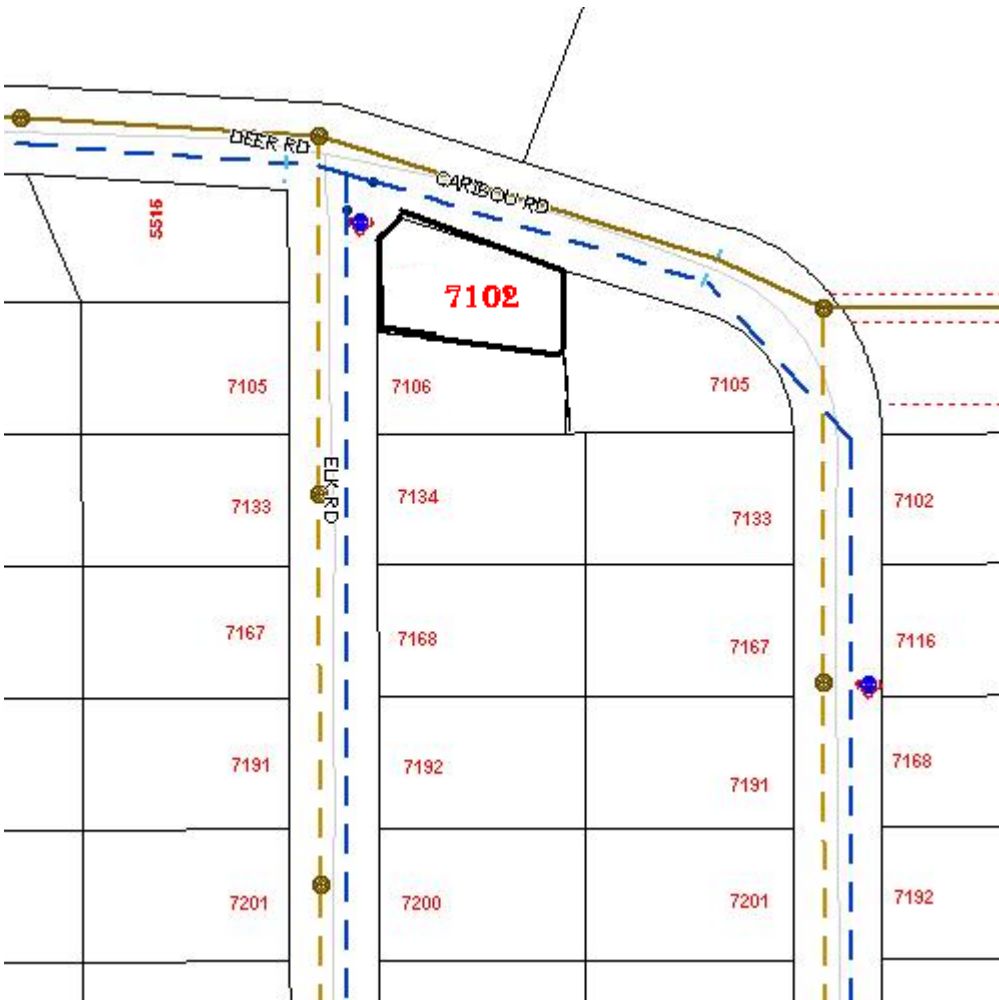

Accuracy not guaranteed unless confirmed by site inspection and/or investigation.
Connection location between main and property line only.