



City of Prince George  
**History Sheet**

PID:	027452913
SD/MU:	
WO:	36360

Civic Address: 2847 Andres Rd

Legal Description: Lot: 1 District Lot: 1433 Plan: BCP35639


Service Type	Diameter (mm)	Material	Invert Elev at main (m)	Depth of Cut at property line (m)	Invert Elev at service end (m)	Distance into property (m)	Installation Date
Sanitary	100mm	PVC	-	2.87	-	-	October 2008
Water	20mm	Copper	-	-	-	-	-October 2008
Storm	100mm	PVC	-	-	-	-	October 2008

Service Connection Location				Sanitary (m)	Storm (m)
Distance from downstream San MH	4087	towards upstream San MH	4088	47.10	
Distance from downstream Stm MH	1609	towards upstream Stm MH	1610		44.30

Power	Size	Communications	Size	Cable	Size	Gas	Size
BC Hydro	-	Telus	-	Shaw	-	FortisBC	-
Overhead Service		Overhead Service		Overhead Service			

Installed by:	City of Prince George forces	Survey Date:	-
Comments:			

**NOT TO SCALE** The information contained herein is for internal use only.  
Not to be relied on unless confirmed by site inspection and/or investigation.

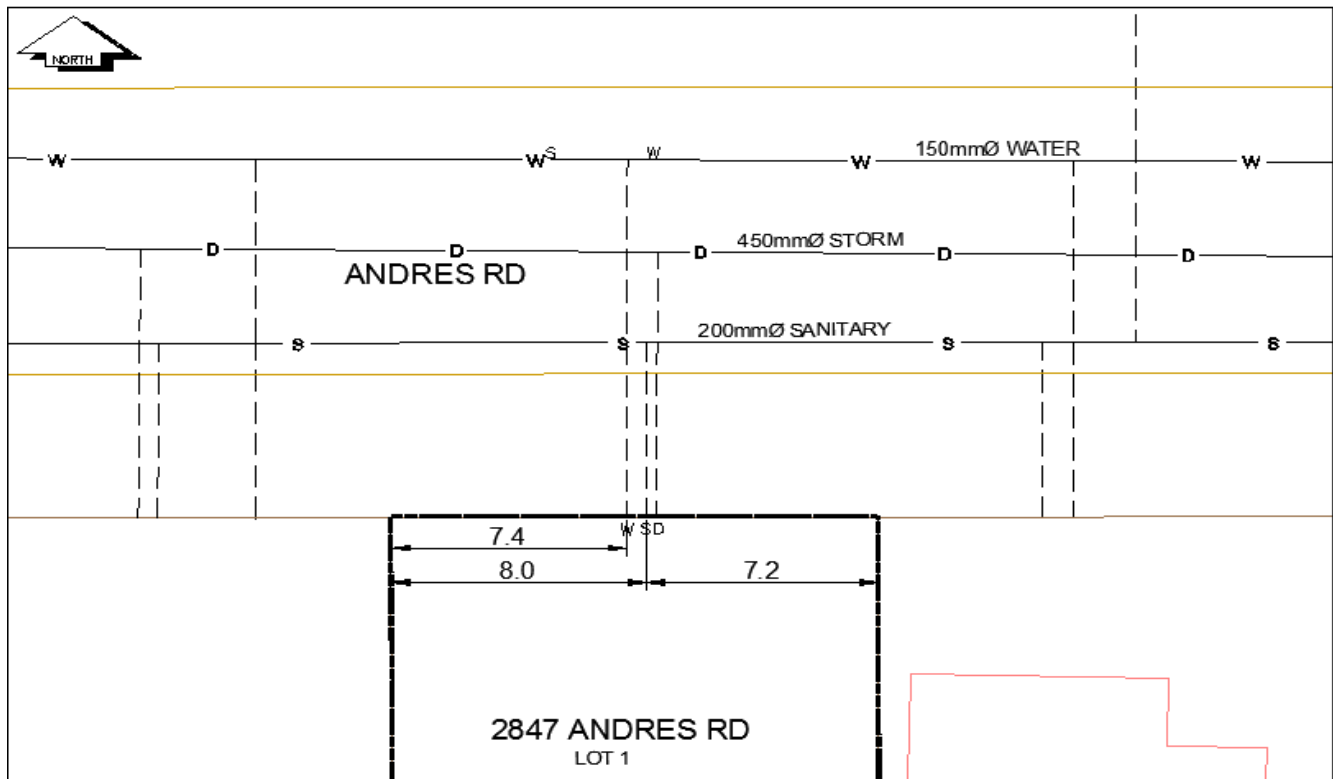

LEGEND:	CS <sup>o</sup> CURB STOP	--- -- -- -- -- WATER SERVICE	--- -- -- -- -- Δ STORM SERVICE
	CD <sup>o</sup> CLEAN OUT	--- -- -- -- -- S SANITARY SERVICE	--- G --- GAS

**NOT TO SCALE**