



City of Prince George
History Sheet

PID:	027452930
SD/MU:	
WO:	36359

Civic Address: 2851 Andres Rd

Legal Description: Lot: 2 District Lot: 1433 Plan: BCP35639


Service Type	Diameter (mm)	Material	Invert Elev at main (m)	Depth of Cut at property line (m)	Invert Elev at service end (m)	Distance into property (m)	Installation Date
Sanitary	100mm	PVC	-	-	-	-	-
Water	20mm	Copper	-	-	-	-	-
Storm	100mm	PVC	-	-	-	-	-

Service Connection Location				Sanitary (m)	Storm (m)
Distance from downstream San MH	4087	towards upstream San MH	4088	62.30	
Distance from downstream Stm MH	1609	towards upstream Stm MH	1610		60.40

Power	Size	Communications	Size	Cable	Size	Gas	Size
BC Hydro	-	Telus	-	Shaw	-	FortisBC	-
Underground Service		Underground Service		Underground Service			

Installed by:	City of Prince George forces	Survey Date:	-
Comments:			

NOT TO SCALE The information contained herein is for internal use only.
Not to be relied on unless confirmed by site inspection and/or investigation.

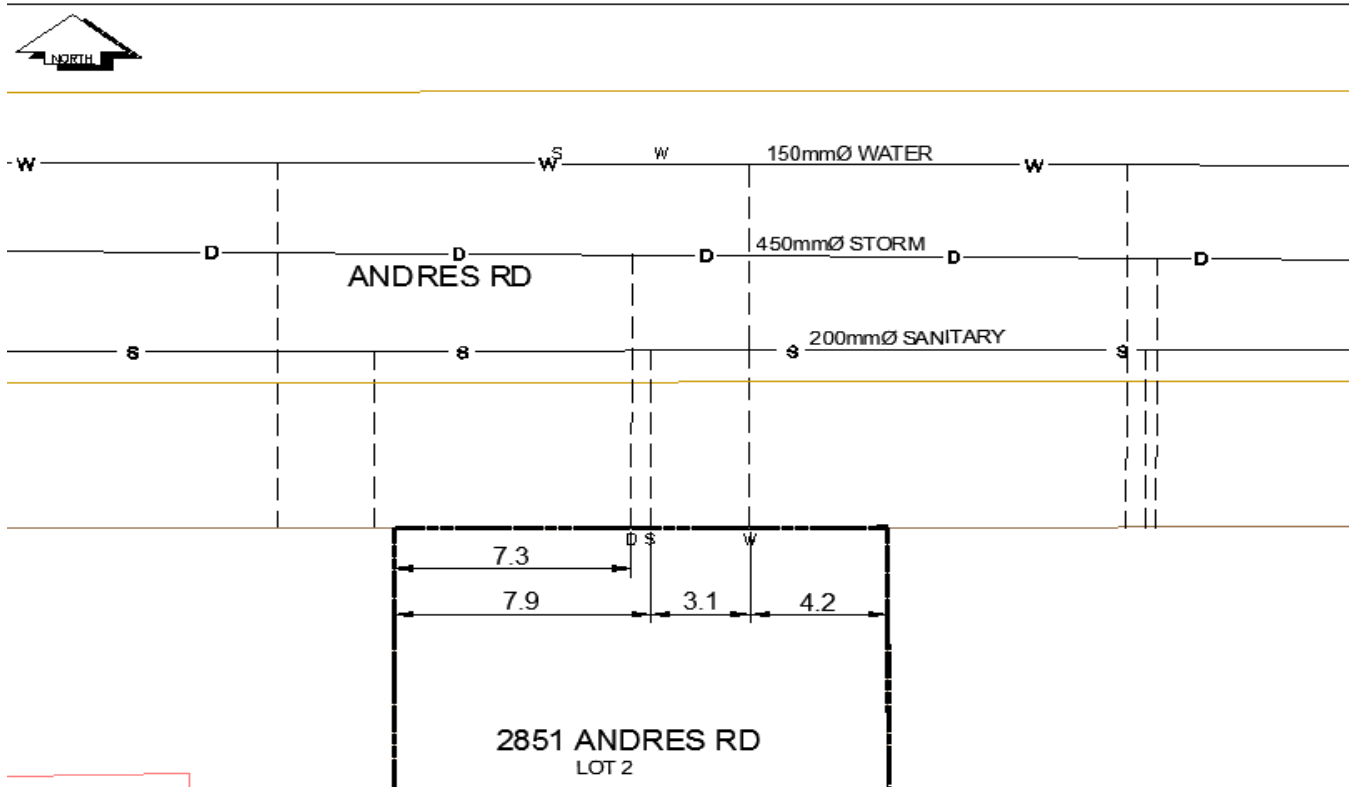

LEGEND:	CS ^o CURB STOP	— — — — — WATER SERVICE	— — — — — STORM SERVICE
	CO ^o CLEAN OUT	— — — — — SANITARY SERVICE	— — — — — GAS

NOT TO SCALE