


## Lot Servicing

HARPER ST

PID: 027457176

**Lot:** PCL A, **Block:** 41, **Plan:** 646, **DL:** 1429

SERVICE	SIZE	MATERIAL	INSTALLED DATE	LOCATION	DETAILS
NO SERVICES				NO SERVICES	

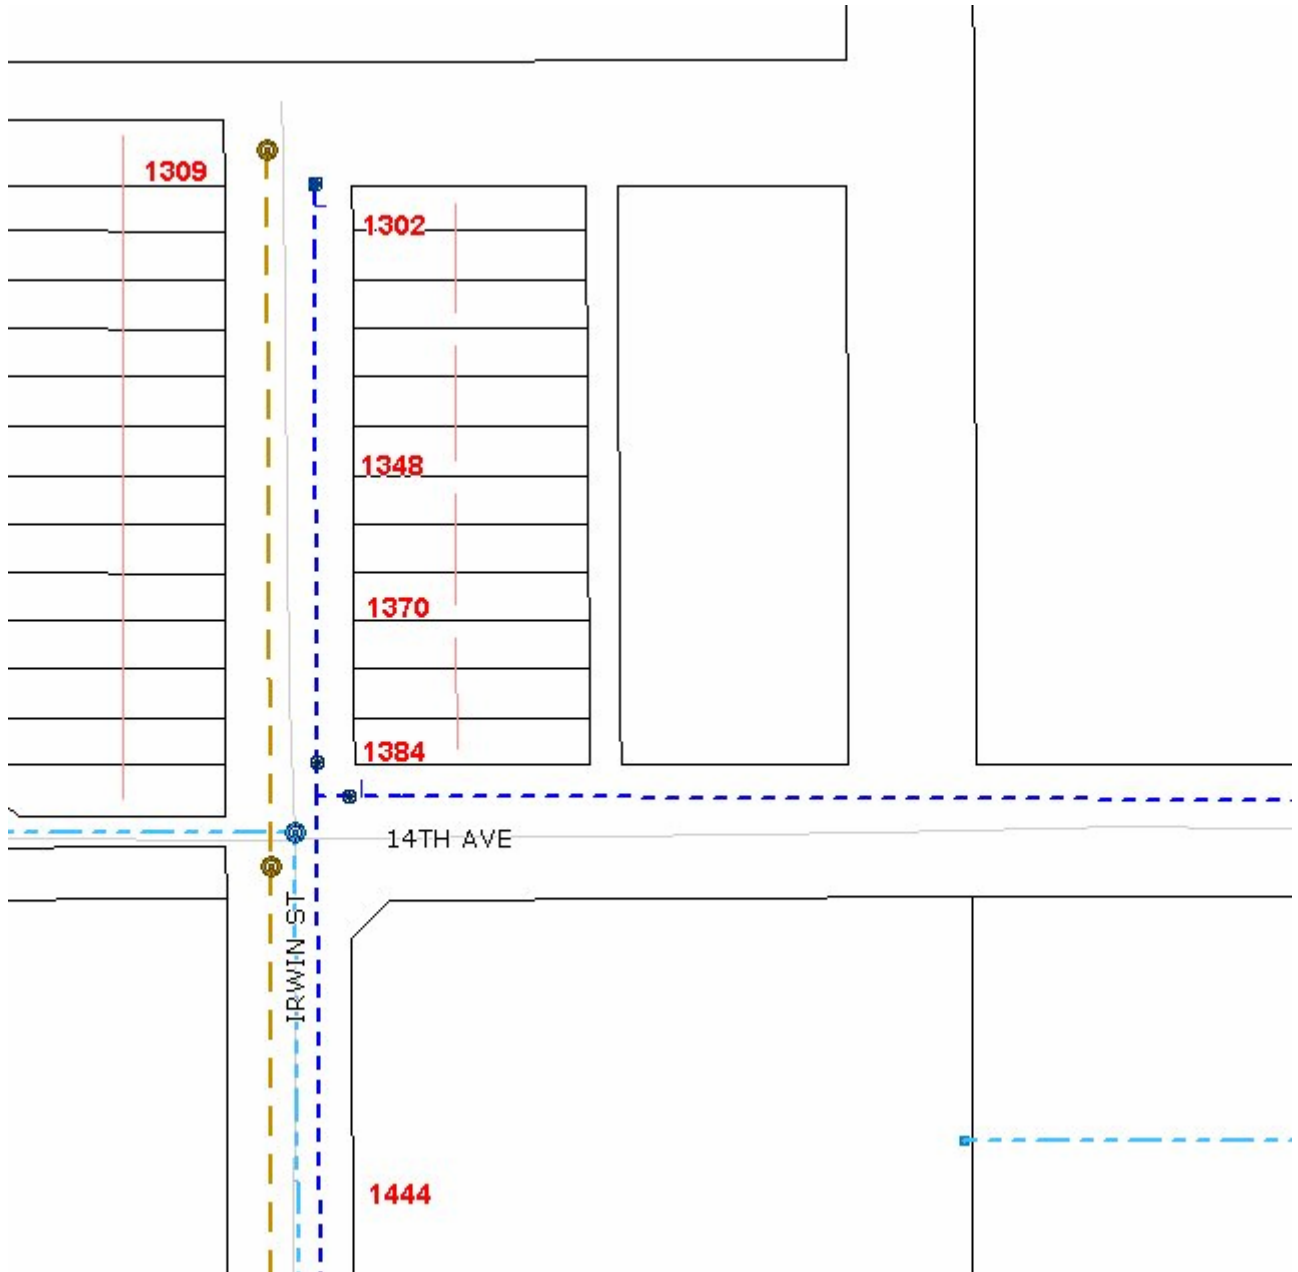

Accuracy not guaranteed unless confirmed by site inspection and/or investigation.  
Connection location between main and property line only.