


## Lot Servicing

2642 CAPELLA DR

PID: 027500233

**Lot: 1, Plan: BCP36110, DL: 753**

SERVICE	SIZE	MATERIAL	INSTALLED DATE	LOCATION	DETAILS
WATER	UNKNOWN	UNKNOWN		FR NW COR BLDG 15.5M W 7.6M N	
SANITARY	100MM	UNKNOWN		1.2M N OF S PL	CONNECTION # 12517

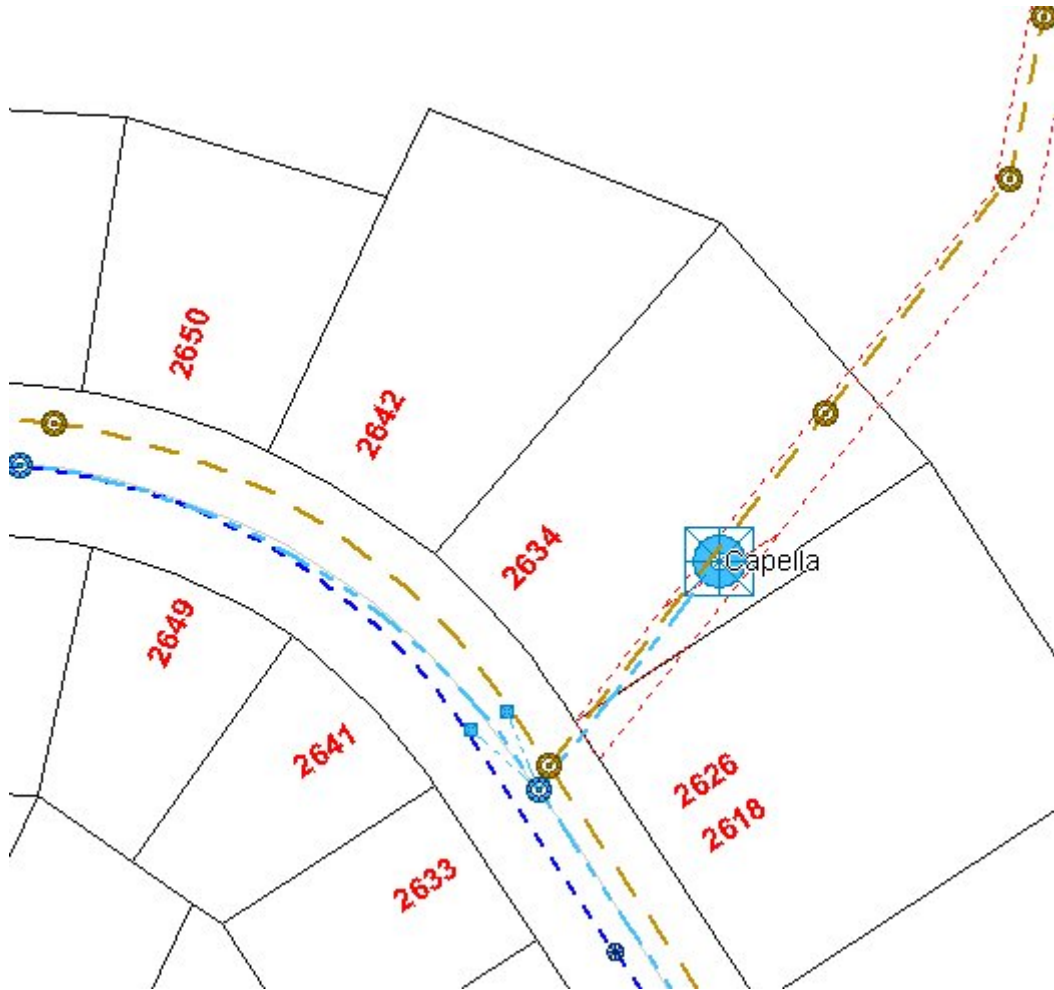

Accuracy not guaranteed unless confirmed by site inspection and/or investigation.  
Connection location between main and property line only.