


## Lot Servicing

4422 KIMBALL RD

PID: 027501051

Lot: PCL 1, Plan: BCP36151, DL: 1599

SERVICE	SIZE	MATERIAL	INSTALLED DATE	LOCATION	DETAILS
WATER	UNKNOWN	UNKNOWN		NO LOCATION	
SANITARY	150MM	PVC		10.0M N OF S PL	DIFF OR CUT BELOW @ P/L 3.00M

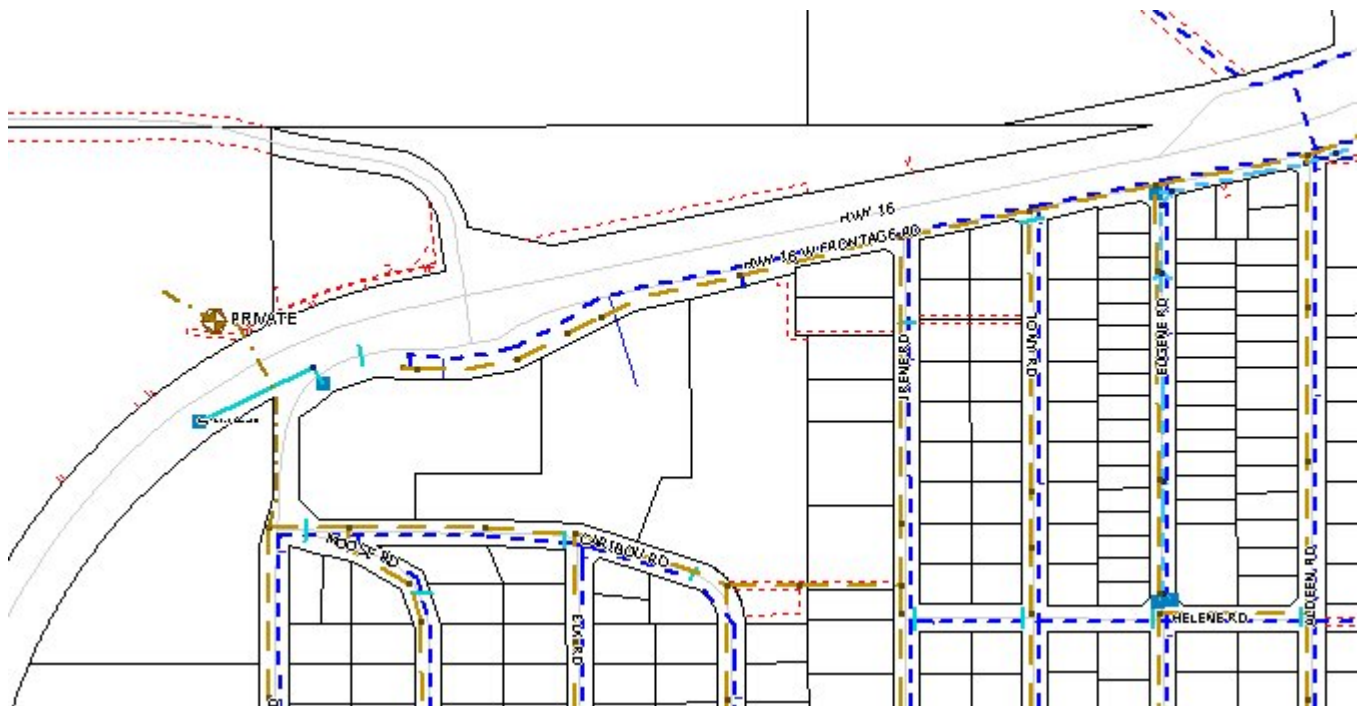

Accuracy not guaranteed unless confirmed by site inspection and/or investigation.  
Connection location between main and property line only.