



City of Prince George History Sheet

PID:	027513971
SD/MU:	
WO:	

Civic Address: 5980 Kovachich Dr

Legal Description: Lot: 1 District Lot: 633 Plan: BCP36349


Service Type	Diameter (mm)	Material	Invert Elev at main (m)	Invert Elev at property line (m)	Invert Elev at service end (m)	Distance into property (m)	Installation Date
Sanitary	100mm	PVC	-	-	-	-	December 1987
Water	20mm	Copper	-	-	-	-	December 1978
Storm	N/A	N/A	-	-	-	-	

Service Connection Location				Sanitary (m)	Storm (m)
Distance from downstream San MH	2915	towards upstream San MH	2917	44.90	
Distance from downstream Stm MH	-	towards upstream Stm MH	-		

Power	Size	Communications	Size	Cable	Size	Gas	Size
BC Hydro	-	Telus	-	Shaw	-	FortisBC	-
Overhead Service		Overhead Service		Overhead Service			

Installed by:	Survey Date:	-
Comments:		

NOT TO SCALE The information contained herein is for internal use only.
Not to be relied on unless confirmed by site inspection and/or investigation.

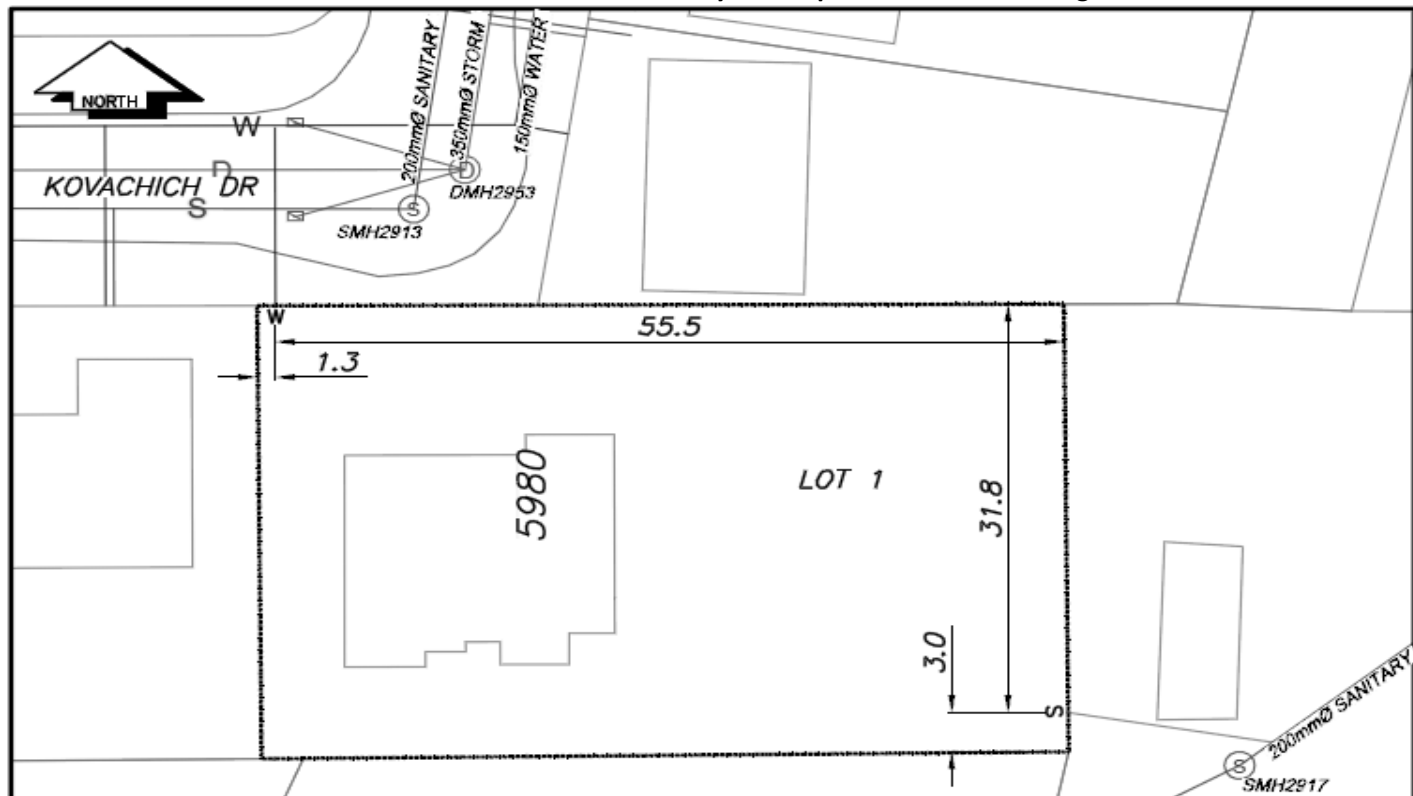

CS ^o CURB STOP	— W — WATER SERVICE	— O — STORM SERVICE
CO ^o CLEAN OUT	- - - S - SANITARY SERVICE	— G — GAS
⊗ WATER VALVE	⊗ FIRE HYDRANT	- - - ENCUMBRANCE

NOT TO SCALE