

City of Prince George
HISTORY SHEET

PID: 027542548

Scale: 1:500

Legal: LOT 4

D.L.: 1605

PLAN: BCP36464

Address: 7647 EASTVIEW STREET

Sanitary Connection:# SIZE: 100mmØ MATERIAL PVC INV. 691.04m CONNECTED

Water Connection:# SIZE: 19mmØ MATERIAL: COPPER INV. 691.04m

Storm Connection:# SIZE 100mmØ MATERIAL PVC INV. 691.06m CONNECTED

Cash Receipt No's: WATER SANITARY STORM

CURB FROM PROPERTY LINE 5m PAVEMENT WIDTH 10m

B.C. HYDRO 75mm DB2 U/G CONNECTION ✓

B.C. TELEPHONE 50mm DB2 U/G CONNECTION ✓


B.C. GAS 42 PROP /P.E

Information Sheets: REF. DWGS. L&M ENGINEERING LTD. JOB. 1106-06-04 DWGS. (001-306)

Comments: CS CURB STOP SDW WATER SERVICE TCH HYDRO SERVICE
CO CLEAN OUT SDW STORM SERVICE TCH CABLE SERVICE
SDW SANITARY SERVICE TCH TELECOMMUNICATIONS GAS GAS
E ELECTRICAL

THE INFORMATION CONTAINED HEREIN IS FOR INTERNAL USE ONLY.

NOT TO BE RELIED UPON UNLESS CONFIRMED BY THE SITE INSPECTION AND/OR INVESTIGATION

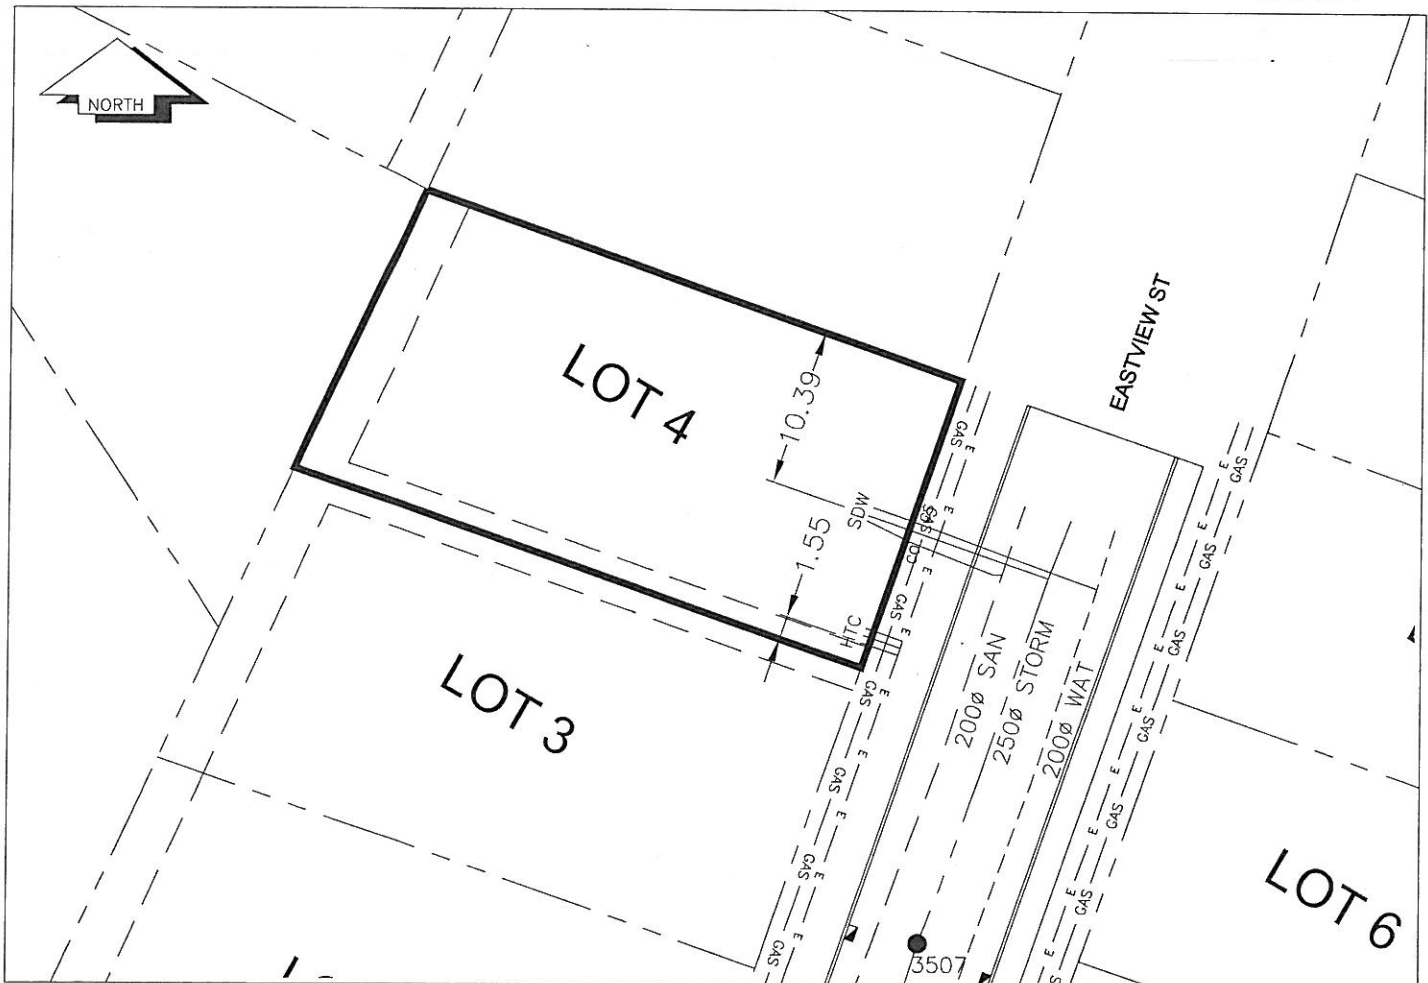

SANITARY, STORM & WATER SERVICE INVERTS	SANITARY	WATER	STORM
1. Distance from San. M.H. 5005 toward San. M.H. Stub to lot service connection point is:	53.8m	N/A	N/A
1a. Distance from Stm. M.H. 3507 toward Stm. M.H. Stub to lot service connection point is:	N/A	N/A	24.6m
2. Main Size at connection point is	200mmØ	200mmØ	250mmØ
3. Invert of main at conn. stub pt is	690.40m	690.11m	690.56m
4. Invert at service end is	691.04m	691.04m	691.06m
5. Cover at P/L in meters	2.44m	2.34m	2.32m
6. Survey Date: NOV,14,07 Book Ref.: 1106-06-03 By: FORESIGHT			

SANITARY HISTORY:

DATE INSTALLED: AUGUST 2007

INSTALLED BY: WESTERN INDUSTRIAL CONTRACTORS LTD

WATER HISTORY:

DATE INSTALLED: AUGUST 2007

INSTALLED BY: WESTERN INDUSTRIAL CONTRACTORS LTD

STORM HISTORY:

DATE INSTALLED: AUGUST 2007

INSTALLED BY: WESTERN INDUSTRIAL CONTRACTORS LTD