

**City of Prince George**  
**HISTORY SHEET**

PID: 027542556

Scale: 1:500

Legal: LOT 5

D.L.: 1605

PLAN: BCP36464

Address: 7652 EASTVIEW STREET

|                       |              |              |              |           |
|-----------------------|--------------|--------------|--------------|-----------|
| Sanitary Connection:# | SIZE: 100mmØ | MATERIAL PVC | INV. 691.12m | CONNECTED |
|-----------------------|--------------|--------------|--------------|-----------|

|                    |             |                  |              |  |
|--------------------|-------------|------------------|--------------|--|
| Water Connection:# | SIZE: 19mmØ | MATERIAL: COPPER | INV. 691.16m |  |
|--------------------|-------------|------------------|--------------|--|

|                    |             |              |              |           |
|--------------------|-------------|--------------|--------------|-----------|
| Storm Connection:# | SIZE 100mmØ | MATERIAL PVC | INV. 691.14m | CONNECTED |
|--------------------|-------------|--------------|--------------|-----------|

|                    |       |          |       |
|--------------------|-------|----------|-------|
| Cash Receipt No's: | WATER | SANITARY | STORM |
|--------------------|-------|----------|-------|

|                         |    |                |     |
|-------------------------|----|----------------|-----|
| CURB FROM PROPERTY LINE | 5m | PAVEMENT WIDTH | 10m |
|-------------------------|----|----------------|-----|

|            |          |                |   |
|------------|----------|----------------|---|
| B.C. HYDRO | 75mm DB2 | U/G CONNECTION | ✓ |
|------------|----------|----------------|---|

|                |          |                |   |
|----------------|----------|----------------|---|
| B.C. TELEPHONE | 50mm DB2 | U/G CONNECTION | ✓ |
|----------------|----------|----------------|---|


|          |              |  |  |
|----------|--------------|--|--|
| B.C. GAS | 42 PROP /P.E |  |  |
|----------|--------------|--|--|

Information Sheets: REF. DWGS. L&M ENGINEERING LTD. JOB. 1106-06-04 DWGS. (001-306)

|           |              |                      |                        |         |
|-----------|--------------|----------------------|------------------------|---------|
| Comments: | CS CURB STOP | SDW WATER SERVICE    | TCH HYDRO SERVICE      | GAS GAS |
|           | CO CLEAN OUT |                      |                        |         |
|           |              | SDW SANITARY SERVICE | TCH TELECOMMUNICATIONS |         |

THE INFORMATION CONTAINED HEREIN IS FOR INTERNAL USE ONLY.

NOT TO BE RELIED UPON UNLESS CONFIRMED BY THE SITE INSPECTION AND/OR INVESTIGATION

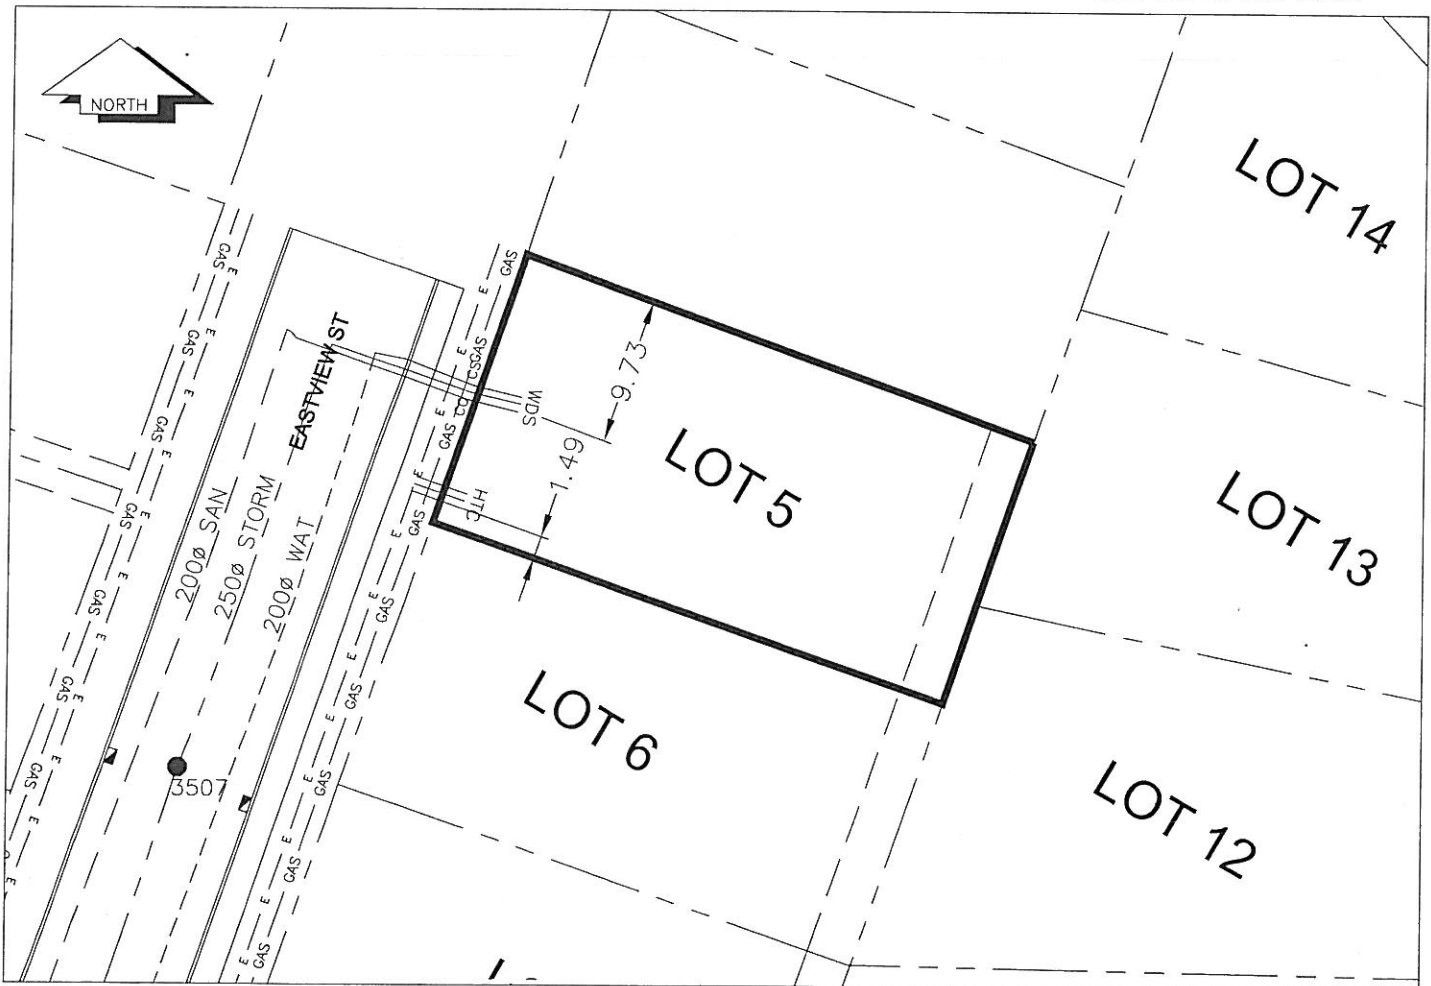

| SANITARY, STORM & WATER SERVICE INVERTS   | SANITARY | WATER   | STORM   |
|---|----------|---------|---------|
| 1. Distance from San. M.H. 5002 toward San. M.H. Stub to lot service connection point is: | 59.5m    | N/A     | N/A     |
| 1a.Distance from Stm. M.H. 3507 toward Stm. M.H. Stub to lot service connection point is: | N/A      | N/A     | 28.5m   |
| 2. Main Size at connection point is   | 200mmØ   | 200mmØ  | 250mmØ  |
| 3. Invert of main at conn. stub pt is   | 690.39m  | 690.11m | 690.56m |
| 4. Invert at service end is   | 691.12m  | 691.16m | 691.14m |
| 5. Cover at P/L in meters   | 2.25m    | 2.31m   | 2.23m   |
| 6. Survey Date: NOV,14,07 Book Ref.: 1106-06-03 By: FORESIGHT                             |          |         |         |
|   |          |         |         |
|   |          |         |         |
SANITARY HISTORY:

DATE INSTALLED: AUGUST 2007

INSTALLED BY: WESTERN INDUSTRIAL CONTRACTORS LTD

---

---

WATER HISTORY:

DATE INSTALLED: AUGUST 2007

INSTALLED BY: WESTERN INDUSTRIAL CONTRACTORS LTD

---

---

STORM HISTORY:

DATE INSTALLED: AUGUST 2007

INSTALLED BY: WESTERN INDUSTRIAL CONTRACTORS LTD

---

---

