

# City of Prince George

## HISTORY SHEET

PID: 027542637

Scale: 1:500

Legal: LOT 13

D.L.: 1605

PLAN: BCP36464

Address: 7663 ST ANDREW PLACE

Sanitary Connection:# SIZE: 100mmØ MATERIAL: PVC INV. 686.89m CONNECTED

Water Connection:# SIZE: 19mmØ MATERIAL: COPPER INV. 685.27m

Storm Connection:# SIZE: 100mmØ MATERIAL: PVC INV. 685.25m CONNECTED

Cash Receipt No's: WATER SANITARY STORM

CURB FROM PROPERTY LINE 5m PAVEMENT WIDTH 10m

B.C. HYDRO 75mm DB2 U/G CONNECTION ✓


B.C. TELEPHONE 50mm DB2 U/G CONNECTION ✓

B.C. GAS 42 PROP /P.E

Information Sheets: REF. DWGS. L&M ENGINEERING LTD. JOB. 1106-06-04 DWGS. (001-306)

Comments: CS CURB STOP SDW WATER SERVICE TCH HYDRO SERVICE GAS GAS  
CO CLEAN OUT SDW STORM SERVICE TCH CABLE SERVICE E ELECTRICAL  
SDW SANITARY SERVICE TCH TELECOMMUNICATIONS

THE INFORMATION CONTAINED HEREIN IS FOR INTERNAL USE ONLY.  
NOT TO BE RELIED UPON UNLESS CONFIRMED BY THE SITE INSPECTION AND/OR INVESTIGATION

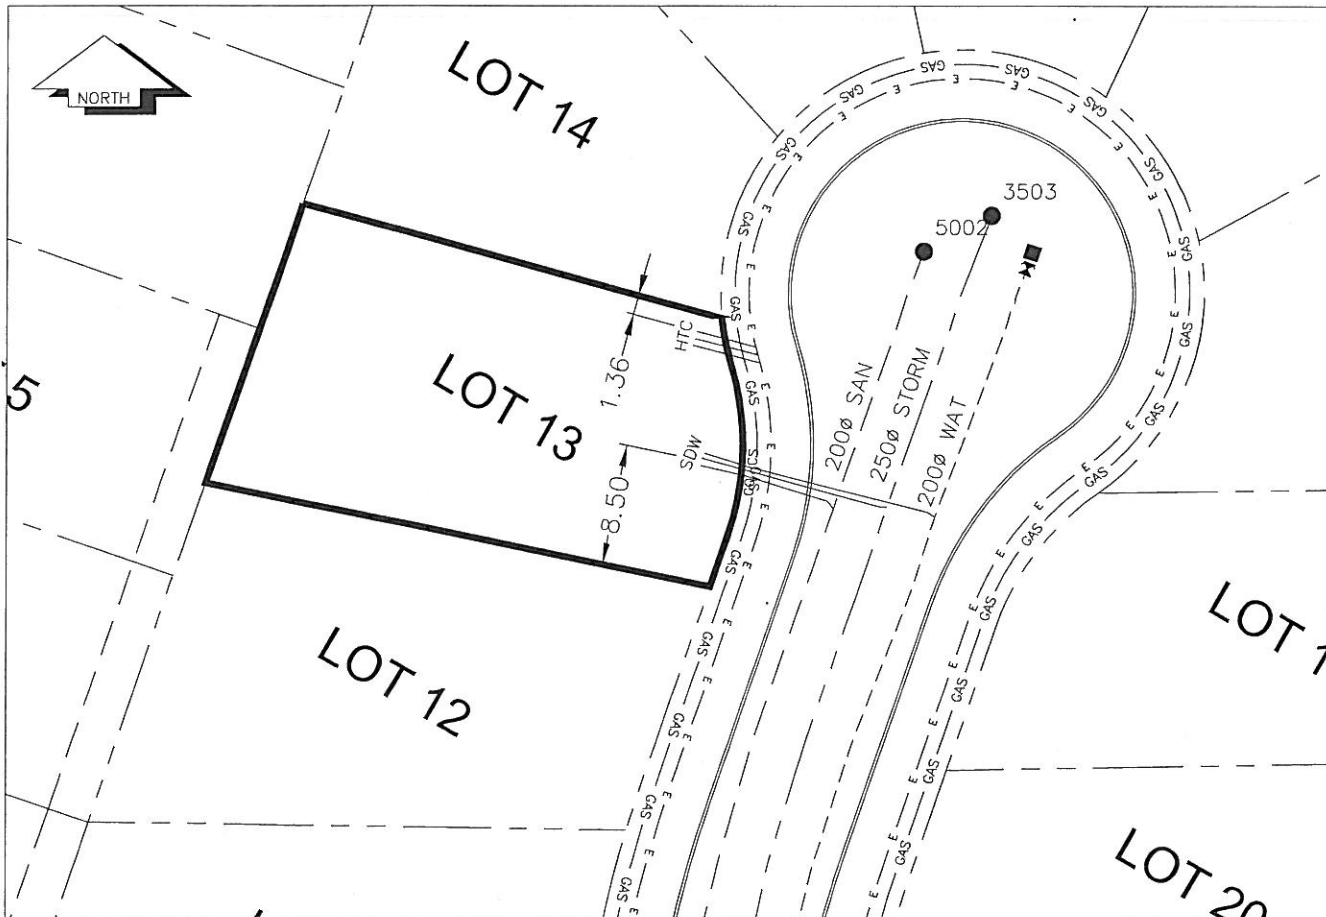

SANITARY, STORM & WATER SERVICE INVERTS	SANITARY	WATER	STORM
1. Distance from San. M.H. 3503 toward San. M.H. 3502 to lot service connection point is:	17m	N/A	N/A
1a. Distance from Strm. M.H. 5002 toward Strm. M.H. 5001 to lot service connection point is:	N/A	N/A	20m
2. Main Size at connection point is	200mmØ	200mmØ	250mmØ
3. Invert of main at conn. stub pt is	684.56m	684.31m	684.71m
4. Invert at service end is	685.26m	685.27m	685.25m
5. Cover at P/L in meters	2.17m	2.31m	2.24m
6. Survey Date: NOV,14,07 Book Ref.: 1106-06-03 By: FORESIGHT			

**SANITARY HISTORY:**

DATE INSTALLED: AUGUST 2007

INSTALLED BY: WESTERN INDUSTRIAL CONTRACTORS LTD

---

---

**WATER HISTORY:**

DATE INSTALLED: AUGUST 2007

INSTALLED BY: WESTERN INDUSTRIAL CONTRACTORS LTD

---

---

**STORM HISTORY:**

DATE INSTALLED: AUGUST 2007

INSTALLED BY: WESTERN INDUSTRIAL CONTRACTORS LTD

---

---

