

City of Prince George

HISTORY SHEET

PID: 027542726

Scale: 1:500

Legal: LOT 21

D.L.: 1605

PLAN: BCP36464

Address: 7686 ST ANDREW PLACE

Sanitary Connection:# SIZE: 100mmØ MATERIAL PVC INV. 684.30m CONNECTED

Water Connection:# SIZE: 19mmØ MATERIAL: COPPER INV. 684.48m

Storm Connection:# SIZE 100mmØ MATERIAL PVC INV. 684.32m CONNECTED

Cash Receipt No's: WATER SANITARY STORM

CURB FROM PROPERTY LINE 5m PAVEMENT WIDTH 10m

B.C. HYDRO 75mm DB2 U/G CONNECTION ✓

B.C. TELEPHONE 50mm DB2 U/G CONNECTION ✓


B.C. GAS 42 PROP /P.E

Information Sheets: REF. DWGS. L&M ENGINEERING LTD. JOB. 1106-06-04 DWGS. (001-306)

Comments: CS CURB STOP SDW WATER SERVICE TCH HYDRO SERVICE
CO CLEAN OUT STORM SERVICE CABLE SERVICE
SANITARY SERVICE TELECOMMUNICATIONS GAS ELECTRICAL

THE INFORMATION CONTAINED HEREIN IS FOR INTERNAL USE ONLY.

NOT TO BE RELIED UPON UNLESS CONFIRMED BY THE SITE INSPECTION AND/OR INVESTIGATION

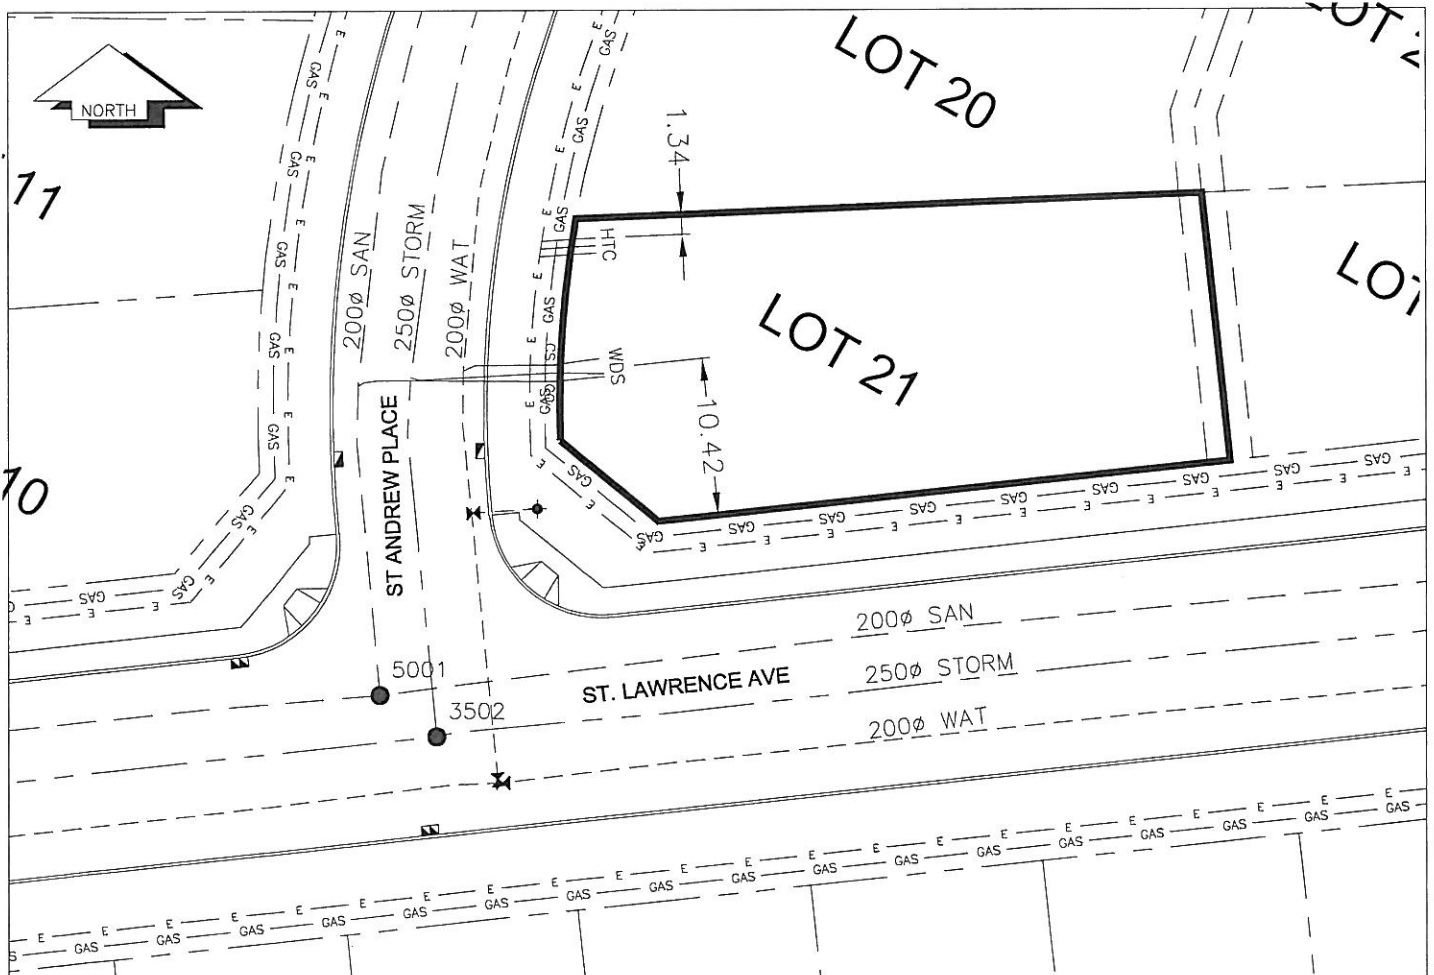

SANITARY, STORM & WATER SERVICE INVERTS	SANITARY	WATER	STORM
1. Distance from San. M.H. 5001 toward San. M.H. 5002 to lot service connection point is:	21m	N/A	N/A
1a.Distance from Stm. M.H. 3502 toward Stm. M.H. 3503 to lot service connection point is:	N/A	N/A	24m
2. Main Size at connection point is	200mmØ	200mmØ	250mmØ
3. Invert of main at conn. stub pt is	683.06m	684.00m	683.65m
4. Invert at service end is	684.30m	684.48m	684.32m
5. Cover at P/L in meters	2.57m	2.49m	2.55m
6. Survey Date: NOV,14,07 Book Ref.: 1106-06-03 By: FORESIGHT			

SANITARY HISTORY:

DATE INSTALLED: AUGUST 2007

INSTALLED BY: WESTERN INDUSTRIAL CONTRACTORS LTD

WATER HISTORY:

DATE INSTALLED: AUGUST 2007

INSTALLED BY: WESTERN INDUSTRIAL CONTRACTORS LTD

STORM HISTORY:

DATE INSTALLED: AUGUST 2007

INSTALLED BY: WESTERN INDUSTRIAL CONTRACTORS LTD